


15-039-20548-00-00

STATE OF KANSAS
STATE CORPORATION COMMISSION

WELL PLUGGING RECORD

Give All Information Completely
Make Required Affidavit
Mail or Deliver Report to
Conservation Division
State Corporation Comm.
245 North Water
Wichita, KS 67202

Decatur County, Sec. 23 Twp. 3S Rge. 27WE/W
Location as "NE/CNW $\frac{1}{4}$ SW $\frac{1}{4}$ " or footage from lines
950' FWL & 1350' FNL
Lease Owner Murfin Drilling Company
Lease Name Robertson Well No. 2-23
Office Address 617 Union Ctr. Bldg., Wichita, KS 67202
Character of Well (Completed as Oil, Gas or Dry Hole)
dry hole

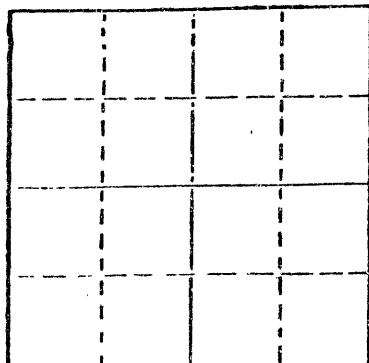

Locate well correctly on above
Section Plat

Date Well completed 12-3-80 19
Application for plugging filed 12-3-80 19
Application for plugging approved 12-3-80 19
Plugging commenced 12-3-80 19
Plugging completed 12-3-80 19
Reason for abandonment of well or producing formation
dry hole
If a producing well is abandoned, date of last production

Was permission obtained from the Conservation Division or
its agents before plugging was commenced? yes

Name of Conservation Agent who supervised plugging of this well Duane Rankin, Gt. Bend, KS
Producing formation _____ Depth to top _____ Bottom _____ Total Depth of Well 3622'
Show depth and thickness of all water, oil and gas formations.

OIL, GAS OR WATER RECORDS

CASING RECORD

FORMATION	CONTENT	FROM	TO	SIZE	PUT IN	PULLED OUT
				8-5/8"	181'	none

Describe in detail the manner in which the well was plugged, indicating where the mud fluid
was placed and the method or methods used in introducing it into the hold. If cement or other
plugs were used, state the character of same and depth placed, from _____ feet to
_____ feet for each plug set.

1st plug @ 1300' w/70 sx.
2nd plug @ 180' w/30 sx.
3rd plug @ 40' w/10 sx.
5 sx. in rat hole
5 sx. in mouse hole.

(If additional description is necessary, use BACK of this sheet)

Name of Plugging Contractor Murfin Drilling Company

STATE OF KANSAS COUNTY OF SEDGWICK, ss.
Wm. S. Shropshire, Asst. Gen. Mgr. (employee of owner) or (owner or operator)
of the above-described well, being first duly sworn on oath, says: That I have knowledge of
the facts, statements, and matters herein contained and the log of the above-described well
as filed and that the same are true and correct. So help me God.


(Signature)

Wm. S. Shropshire
Wm. S. Shropshire, Asst. Gen. Mgr., 617 Union
(Address) Ctr. Bldg., Wichita,
KS 67202

SUBSCRIBED AND SWORN TO before me this 9th day of January, 1981

Laurel Gradert
Laurel Gradert
Notary Public.

My commission expires _____

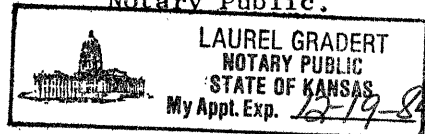

RECEIVED
STATE CORPORATION COMMISSION
1-13-81

JAN 13 1981

CONSERVATION DIVISION
Wichita, Kansas