


Give All Information Completely
Make Required Affidavit
Mail or Deliver Report to:
Conservation Division
State Corporation Commission
800 Bitting Building
Wichita, Kansas

15-039-00622-00-00
WELL PLUGGING RECORD

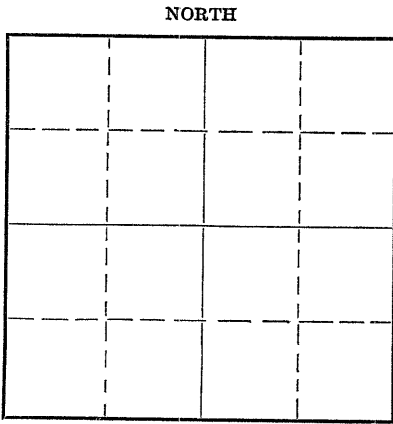

Locate well correctly on above Section Plat

Decatur County. Sec. 26 Twp. 3 Rge. (E) 27 (W)
Location as "NE/CNW 1/4 SW 1/4" or footage from lines NE NE SE
Lease Owner Harry Gore
Lease Name Follis Well No. 1
Office Address 400 Brown Building, Wichita, Kansas
Character of Well (completed as Oil, Gas or Dry Hole) Dry Hole
Date well completed September 12, 19 51
Application for plugging filed September 12, 19 51
Application for plugging approved September 12, 19 51
Plugging commenced September 12, 19 51
Plugging completed September 12, 19 51
Reason for abandonment of well or producing formation

If a producing well is abandoned, date of last production 19
Was permission obtained from the Conservation Division or its agents before plugging was commenced? Yes

Name of Conservation Agent who supervised plugging of this well Eldon Petty, Hays, Kansas
Producing formation Depth to top Bottom Total Depth of Well 4010 Feet
Show depth and thickness of all water, oil and gas formations.

OIL, GAS OR WATER RECORDS

CASING RECORD

Formation	Content	From	To	Size	Put In	Pulled Out
				8-5/8"	219'	Cemented

Describe in detail the manner in which the well was plugged, indicating where the mud fluid was placed and the method or methods used in introducing it into the hole. If cement or other plugs were used, state the character of same and depth placed, from feet to feet for each plug set.

Mud from 4010 to 210' - Ran plug and 1/2 sack hulls and 15 sacks cement. Mud from 210 to 40' - Ran Plug and 1/2 sack hulls and 10 sacks cement - Cemented to base of cellar.

RECEIVED
STATE CORPORATION COMMISSION
SEP 28 1951
CONSERVATION DIVISION

(If additional description is necessary, use BACK of this sheet)

Correspondence regarding this well should be addressed to Harry Gore
Address 400 Brown Bldg.
Wichita, Kansas

9-20-51

STATE OF KANSAS, COUNTY OF MONTGOMERY, ss.
LEO G. VEEDER (employee of owner) or (owner or operator) of the above-described well,

being first duly sworn on oath, says: That I have knowledge of the facts, statements, and matters herein contained and the log of the above-described well as filed and that the same are true and correct. So help me God THE VEEDER SUPPLY & DEVELOPMENT COMPANY

(Signature) Leo G. Veeder

P. O. Box 201, Cherryvale, Kansas
(Address)

SUBSCRIBED AND SWORN to before me this 21st day of September, 19 51

Leo Larsson
Notary Public.

My commission expires July 11, 1952

PLUGGING
FILE SEC 26 T 3 R 27 W
BOOK PAGE 109 LINE 10