

15-153-05134-00-00

STATE OF KANSAS  
STATE CORPORATION COMMISSION

Give All Information Completely  
Make Required Affidavit  
Mail or Deliver Report to:  
Conservation Division  
State Corporation Commission  
211 No. Broadway  
Wichita, Kansas

WELL PLUGGING RECORD

RAWLINS

County. Sec. 7 Twp. 2S Rge. 36 (E) N (W)

Location as "NE/CNW/SW" or footage from lines C NW/SE/SE

Lease Owner Miami Petroleum Company, Inc.

Lease Name Fred Brumm "F" Well No. 2

Office Address P.O. Drawer 2040, Abilene, Texas

Character of Well (completed as Oil, Gas or Dry Hole) Oil

Date well completed May 26, 1959 19

Application for plugging filed herewith 19

Application for plugging approved Verbal & written - October 19 61


Plugging commenced 10/20/61 19

Plugging completed 10/24/61 19

Reason for abandonment of well or producing formation Lease reached economic limits of production

If a producing well is abandoned, date of last production March 18 19 61

Was permission obtained from the Conservation Division or its agents before plugging was commenced? Yes

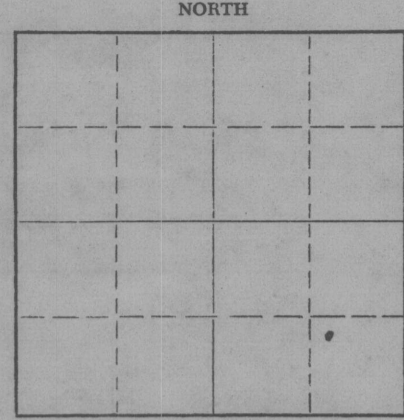

Locate well correctly on above Section Plat

Name of Conservation Agent who supervised plugging of this well Eldon Petty

Producing formation Topeka Depth to top 4228 Bottom 4237 Total Depth of Well 5090 Feet

Show depth and thickness of all water, oil and gas formations.

OIL, GAS OR WATER RECORDS

CASING RECORD

FORMATION	CONTENT	FROM	TO	SIZE	PUT IN	PULLED OUT
Topeka	Oil & gas	4228	4237	5 1/2"	4400'	1807'
				8-5/8"	346'	-0-

Describe in detail the manner in which the well was plugged, indicating where the mud fluid was placed and the method or methods used in introducing it into the hole. If cement or other plugs were used, state the character of same and depth placed, from \_\_\_\_\_ feet to \_\_\_\_\_ feet for each plug set.

Plugged back to 4100 ft. Put in 25 ft. sand, dumped 4 sacks cement. Pumped in 24 sacks mud at 500 ft. Pulled pipe to 330 ft. Pumped in 25 sacks cement. Capped hole with 10 sacks cement.

RECEIVED  
STATE CORPORATION COMMISSION

NOV 20 1961

CONSERVATION DIVISION  
Wichita, Kansas

11-20-61

(If additional description is necessary, use BACK of this sheet)

Name of Plugging Contractor Central Pipe Pulling Company

Address 1416 Coolidge, Great Bend, Kansas

STATE OF Texas COUNTY OF Taylor, ss. Jack Stivers

(employee of ~~owner~~ or (owner or operator) of the above-described well, being first duly sworn on oath, says: That I have knowledge of the facts, statements, and matters herein contained and the log of the above-described well as filed and that the same are true and correct. So help me God.

(Signature) John Stivers

P. O. Drawer 2040, Abilene, Texas  
(Address)

SUBSCRIBED AND SWORN TO before me this 15 day of November, 19 61

My commission expires June 1, 1963

Marjorie D. Lubbering  
Notary Public.  
Taylor County, Texas





<u>DEPTH</u>		<u>FORMATION</u>
<u>From</u>	<u>To</u>	
4482	4498	Line and Shale
4498	4514	Shale
4514	4600	Line and shale
4600	4708	Shale with lime streaks
4708	4722	Line
4722	4835	Line and shale
4835	4858	Shale
4858	4872	Sand, conglomerate and shale
4872	4998	Sand and shale streaks
4998	5003	Chert
5003	5068	Dolomite and lime with streaks of chert
5068	5090	Line

TOPS:

Blaine Gypsum	3076'
Harper Sand	3146'
Stone Corral	3270'
Harrington	3477'
Topeka	4228'
Lansing-Kansas City	4374'
2nd Zone	4482'
3rd Zone	4472'
Marnaton	4708'
Gilmore City	5068'