


STATE OF KANSAS  
STATE CORPORATION COMMISSION

WELL PLUGGING RECORD

Give All Information Completely  
Make Required Affidavit  
Mail or Deliver Report to  
Conservation Division  
State Corporation Comm.  
245 North Water  
Wichita, KS 67202

Decatur County. Sec. 22 Twp. 3 Rge. 27W E/W  
Location as "NE/CNW $\frac{1}{4}$ SW $\frac{1}{4}$ " or footage from lines  
SE SE NW

Lease Owner Zenith Drilling Corporation, Inc.  
Lease Name KRISEK Well No. 1  
Office Address 200 W. Douglas, Suite 600, Wichita, KS  
Character of Well (Completed as Oil, Gas or Dry Hole)  
Dry Hole

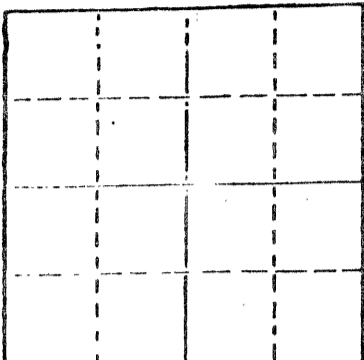

Locate well correctly on above  
Section Plat

Date Well completed June 11 1979  
Application for plugging filed (verbally) June 11 1979  
Application for plugging approved (verbally) June 11 1979  
Plugging commenced June 11 1979  
Plugging completed June 11 1979

Reason for abandonment of well or producing formation  
No commerical quantity of oil or gas encountered  
If a producing well is abandoned, date of last production  
19

Was permission obtained from the Conservation Division or  
its agents before plugging was commenced? Yes

Name of Conservation Agent who supervised plugging of this well Gilbert Balthazor  
Producing formation \_\_\_\_\_ Depth to top \_\_\_\_\_ Bottom \_\_\_\_\_ Total Depth of Well 3815'  
Show depth and thickness of all water, oil and gas formations.

OIL, GAS OR WATER RECORDS

CASING RECORD

FORMATION	CONTENT	FROM	TO	SIZE	PUT IN	PULLED OUT

Describe in detail the manner in which the well was plugged, indicating where the mud fluid was placed and the method or methods used in introducing it into the hold. If cement or other plugs were used, state the character of same and depth placed, from \_\_\_\_\_ feet to \_\_\_\_\_ feet for each plug set.

T.D. 3815'

Set 1st plug at 1350' with 70 sacks  
2nd plug at 280' with 20 sacks  
3rd plug at 40' solid bridge with 10 sacks  
rathole with 5 sacks.

Cemented with 50/50 posmix, 6% gel.  
Plug was down at 9:15 p.m., 6-11-79.

(If additional description is necessary, use BACK of this sheet)


Name of Plugging Contractor Abercrombie Drilling, Inc.

RECEIVED  
STATE CORPORATION COMMISSION  
JUN 22 1979  
6-22-79  
WICHITA, KANSAS

STATE OF Kansas COUNTY OF Sedgwick  
Jack L. Partridge, Asst. Sec.-Treas. (employee of owner) or (owner or operator)  
of the above-described well, being first duly sworn on oath, says: That I have knowledge of the facts, statements, and matters herein contained and the log of the above-described well as filed and that the same are true and correct. So help me God.

(Signature) Jack L. Partridge  
801 Union Center, Wichita, Kansas 67202  
(Address)

SUBSCRIBED AND SWORN TO before me this 21st day of June, 19 79

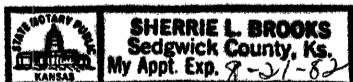

Sherrie L. Brooks  
Sherrie L. Brooks Notary Public.

My commission expires 8-21-82