
15-039-00079-00-00

STATE OF KANSAS
STATE CORPORATION COMMISSION

Give All Information Completely
Make Required Affidavit
Mail or Deliver Report to:
Conservation Division
State Corporation Commission
800 Bitting Building
Wichita, Kansas

WELL PLUGGING RECORD

NORTH

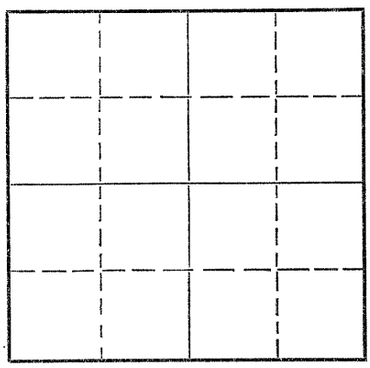

Locate well correctly on above Section Plat

Decatur County. Sec. 7 Twp. 3 Rge. 29 (E) (W)

Location as "NE/CNW¼SW¼" or footage from lines NE NE SE

Lease Owner W. W. Sauvage

Lease Name Larson Well No. 1

Office Address Oberlin, Kansas

Character of Well (completed as Oil, Gas or Dry Hole) dry hole

Date well completed 12-30 19 53

Application for plugging filed 12-30 19 53

Application for plugging approved 12-30 19 53

Plugging commenced 12-31 19 53

Plugging completed 12-31 19 53

Reason for abandonment of well or producing formation dry hole

If a producing well is abandoned, date of last production 19

Was permission obtained from the Conservation Division or its agents before plugging was commenced? yes

Name of Conservation Agent who supervised plugging of this well Eldon Fetty

Producing formation Depth to top Bottom Total Depth of Well 4380 Feet

Show depth and thickness of all water, oil and gas formations.

OIL, GAS OR WATER RECORDS — CASING RECORD

FORMATION	CONTENT	FROM	TO	SIZE	PUT IN	PULLED OUT

Describe in detail the manner in which the well was plugged, indicating where the mud fluid was placed and the method or methods used in introducing it into the hole. If cement or other plugs were used, state the character of same and depth placed, from feet to feet for each plug set.

Filled the hole with heavy mud on bottom, pulled pipe to 1500 and circulated with heavy mud. Pulledpipe and set plug 190 feet ½sx hulls mixed with 15 sx cement through drill pipe and filled with mud to 40 feet with ½ sx hulls and 10 sx cement and filled surface casing to bottom of cellar.

(If additional description is necessary, use BACK of this sheet)

1-5-54

Name of Plugging Contractor Sauvage-Dunn Drilling co., Inc.

Address Oberlin, Kansas

STATE OF Kansas, COUNTY OF Decatur, ss.

Elmer Hoff (employee of owner) or (owner or operator) of the above-described well, being first duly sworn on oath, says: That I have knowledge of the facts, statements, and matters herein contained and the log of the above-described well as filed and that the same are true and correct. So help me God.

(Signature) Elmer Hoff

(Address)

SUBSCRIBED AND SWORN TO before me this 31st day of December, 19 53

Opal Sauvage Notary Public.

My commission expires May 17, 1955

24-7366-S 3-53-20M

PLUGGING
FILE SEC 7 T 3 R 29W
BOOK PAGE 5 LINE 4