

15-039-20233-00-00

STATE OF KANSAS  
STATE CORPORATION COMMISSION


Form CP-4

Give All Information Completely  
Make Required Affidavit  
Mail or Deliver Report to:  
Conservation Division  
State Corporation Commission  
212 No. Market  
Wichita, Kansas 67202

WELL PLUGGING RECORD

Decatur County. Sec. 10 Twp. 3S Rge. (E)29 (W)  
Location as "NE/CNW/SW" or footage from lines 150' N of C NW/4 NW/4  
Lease Owner Abercrombie Drilling, Inc.  
Lease Name ZANDER Well No. 1  
Office Address 801 Union Center, Wichita, Kansas 67202  
Character of Well (completed as Oil, Gas or Dry Hole) Dry Hole  
Date well completed April 21, 1972  
Application for plugging filed (verbally) April 21, 1972  
Application for plugging approved (verbally) April 21, 1972  
Plugging commenced April 21, 1972  
Plugging completed April 21, 1972  
Reason for abandonment of well or producing formation Dry Hole

NORTH

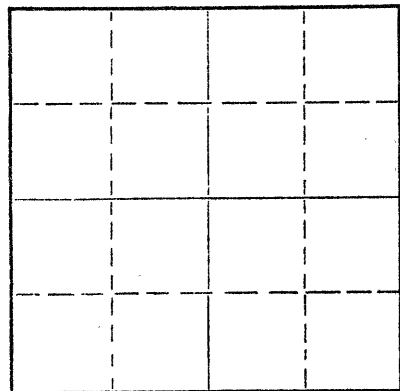

Locate well correctly on above  
Section Plat

If a producing well is abandoned, date of last production 19  
Was permission obtained from the Conservation Division or its agents before plugging was commenced? Yes

Name of Conservation Agent who supervised plugging of this well Bill Nichols  
Producing formation \_\_\_\_\_ Depth to top \_\_\_\_\_ Bottom \_\_\_\_\_ Total Depth of Well 3880 Feet  
Show depth and thickness of all water, oil and gas formations.

OIL, GAS OR WATER RECORDS					CASING RECORD	
FORMATION	CONTENT	FROM	TO	SIZE	PUT IN	PULLED OUT

Describe in detail the manner in which the well was plugged, indicating where the mud fluid was placed and the method or methods used in introducing it into the hole. If cement or other plugs were used, state the character of same and depth placed, from \_\_\_\_\_ feet to \_\_\_\_\_ feet for each plug set.

1st plug was set at 1500' w/110 cu. ft. of cement  
2nd plug was set at 275' w/30 cu. ft. of cement  
Top plug was set at 40' w/10 cu. ft. of cement

RECEIVED  
STATE CORPORATION COMMISSION  
APR 26 1972  
CONSERVATION DIVISION  
Wichita, Kansas

426.72

(If additional description is necessary, use BACK of this sheet)  
Name of Plugging Contractor Abercrombie Drilling, Inc.  
Address 801 Union Center, Wichita, Kansas 67202

STATE OF KANSAS, COUNTY OF SEDGWICK, ss.  
Jerry A. Langrehr (employee of owner) or (owner or operator) of the above-described well, being first duly sworn on oath, says: That I have knowledge of the facts, statements, and matters herein contained and the log of the above-described well as filed and that the same are true and correct. So help me God.

(Signature) Jerry A. Langrehr  
801 Union Center, Wichita, Kansas 67202  
(Address)

SUBSCRIBED AND SWORN TO before me this 25th day of April, 19 72

My commission expires February 10, 1975  
Beverly Mann  
Beverly Mann, Notary Public.