

Give All Information Completely  
Make Required Affidavit  
Mail or Deliver Report to:  
Conservation Division  
State Corporation Commission  
212 No. Market  
Wichita, Kansas

WELL PLUGGING RECORD

DECATUR

County. Sec. 10 Twp. 3 Rge. 29 (E) W (W)

Location as "NE/CNW/SW" or footage from lines C NW NE

Lease Owner OKMAR OIL CO.

Lease Name ZANDER #1

Office Address 1130 WICHITA PLAZA, WICHITA, KANSAS 67202 Well No. \_\_\_\_\_

Character of Well (completed as Oil, Gas or Dry Hole) DRY HOLE

Date well completed NOV. 13, 1968 19\_\_

Application for plugging filed NOV. 13, 1968 19\_\_

Application for plugging approved NOV. 13, 1968 19\_\_


Plugging commenced NOV. 13, 1968 19\_\_

Plugging completed NOV. 13, 1968 19\_\_

Reason for abandonment of well or producing formation TOO LOW STRUCTURALLY

If a producing well is abandoned, date of last production \_\_\_\_\_ 19\_\_

Was permission obtained from the Conservation Division or its agents before plugging was commenced? YES

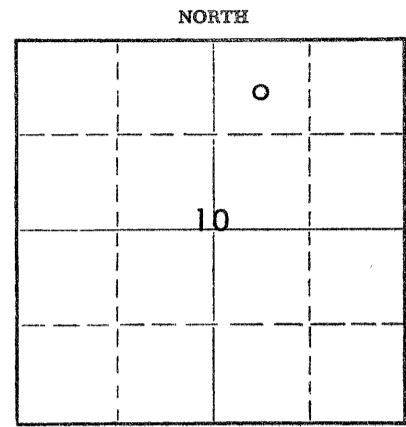

Locate well correctly on above Section Plat

Name of Conservation Agent who supervised plugging of this well W. L. NICHOLS

Producing formation \_\_\_\_\_ Depth to top \_\_\_\_\_ Bottom \_\_\_\_\_ Total Depth of Well 3860 Feet

Show depth and thickness of all water, oil and gas formations.

OIL, GAS OR WATER RECORDS

CASING RECORD

FORMATION	CONTENT	FROM	TO	SIZE	PUT IN	PULLED OUT
				8-5/8"	205.60'	None

RECEIVED  
STATE CORPORATION COMMISSION  
DEC 19 1968  
CONSERVATION DIVISION  
Wichita, Kansas

12-19-68

Describe in detail the manner in which the well was plugged, indicating where the mud fluid was placed and the method or methods used in introducing it into the hole. If cement or other plugs were used, state the character of same and depth placed, from \_\_\_\_\_ feet to \_\_\_\_\_ feet for each plug set.

FILLED WITH HEAVY MUD TO 1550'. SET PLUG. PUT IN 100 SX CEMENT. FILLED WITH HEAVY MUD TO 215'. SET PLUG. PUT IN 20 SX CEMENT. FILLED WITH HEAVY MUD UP TO 40'. SET PLUG. FILLED TO TOP WITH 10 SACKS CEMENT.

Name of Plugging Contractor C-G DRILLING CO. (If additional description is necessary, use BACK of this sheet)  
Address 1107 UNION NATIONAL BLDG, WICHITA, KANSAS 67202

STATE OF KANSAS COUNTY OF SEDGWICK, ss.  
JAY H GALLOWAY (employee of owner) or ~~(owner or operator)~~ of the above-described well, being first duly sworn on oath, says: That I have knowledge of the facts, statements, and matters herein contained and the log of the above-described well as filed and that the same are true and correct. So help me God.

(Signature) Jay H Galloway  
JAY H GALLOWAY 1107 UNION NATL BLDG.  
WICHITA, KANSAS

Subscribed and sworn to before me this 18th day of NOV. 1968  
My commission expires DEC 7, 1971  
Phyllis Buchanan  
PHYLLIS BUCHANAN Notary Public.

