


Give All Information Completely  
Make Required Affidavit  
Mail or Deliver Report to:  
Conservation Division  
State Corporation Commission  
211 No. Broadway  
Wichita, Kansas

WELL PLUGGING RECORD

NORTH

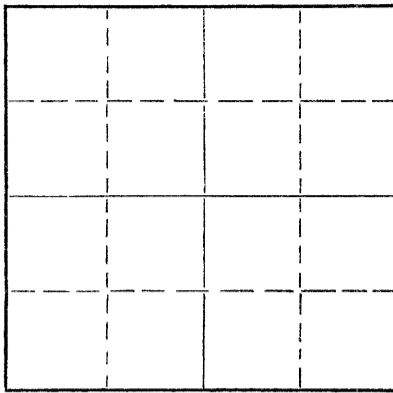

Locate well correctly on above  
Section Plat

Decatur County. Sec. 8 Twp. 3 S Rge. 29 (E) (W)  
Location as "NE/CNW $\frac{1}{4}$ SW $\frac{1}{4}$ " or footage from lines NE SE NE  
Lease Owner Sauvage & Dunn Drig Co Sierra Petro. Co., Inc  
Lease Name Simpson Well No. 1  
Office Address Oberlin, Kansas  
Character of Well (completed as Oil, Gas or Dry Hole) Dry  
Date well completed 5/12/56 19  
Application for plugging filed 5/11/56 19  
Application for plugging approved 5/11/56 19  
Plugging commenced 5/12/56 19  
Plugging completed 5/12/56 19  
Reason for abandonment of well or producing formation Dry

If a producing well is abandoned, date of last production \_\_\_\_\_ 19\_\_\_\_  
Was permission obtained from the Conservation Division or its agents before plugging was commenced? yes

Name of Conservation Agent who supervised plugging of this well Eldon Petty  
Producing formation \_\_\_\_\_ Depth to top \_\_\_\_\_ Bottom \_\_\_\_\_ Total Depth of Well 3923 Feet  
Show depth and thickness of all water, oil and gas formations.

OIL, GAS OR WATER RECORDS

CASING RECORD

FORMATION	CONTENT	FROM	TO	SIZE	PUT IN	PULLED OUT
				8 5/8	200'	none

Describe in detail the manner in which the well was plugged, indicating where the mud fluid was placed and the method or methods used in introducing it into the hole. If cement or other plugs were used, state the character of same and depth placed, from \_\_\_\_\_ feet to \_\_\_\_\_ feet for each plug set.

PLUGGING RECORD

Filled with heavy mud from 3923 up to 185'. Set Halliburton Plug using 1/2 sack hulls and 15 sacks cement. Filled with heavy mud from 155' up to 40' thru drill pipe. Set Wood plug from 40' to 0 Cellar using hulls and 10 sacks cement.

(If additional description is necessary, use BACK of this sheet)

Name of Plugging Contractor Sauvage & Dunn Drilling Co.  
Address Oberlin, Kansas

STATE OF KANSAS, COUNTY OF RUSSELL, ss.  
C. T. Honaker (employee of owner) or (owner or operator) of the above-described well, being first duly sworn on oath, says: That I have knowledge of the facts, statements, and matters herein contained and the log of the above-described well as filed and that the same are true and correct. So help me God.

(Signature) C. T. Honaker

SUBSCRIBED AND SWORN TO before me this 14th day of May, 19 56

My commission expires 1-30-57  
Margie Cooper Notary Public.

**PLUGGING**  
FILE SEC 8 T 3 R 29W  
BOOK PAGE 61 LINE 22

5-15-56  
DIVISION  
KANSAS