

15-039-00549-00-00


STATE OF KANSAS  
STATE CORPORATION COMMISSION

Form CP-4

Give All Information Completely  
Make Required Affidavit  
Mail or Deliver Report to:  
Conservation Division  
State Corporation Commission  
212 No. Market  
Wichita, Kansas

WELL PLUGGING RECORD

NORTH

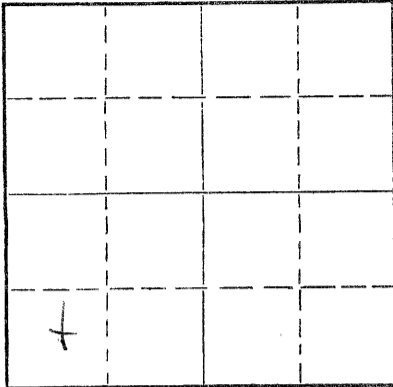

Locate well correctly on above  
Section Plat

Decatur County, Sec. 4 Twp. 3 Rge. 24 (W)  
Location as "NE/CNW/SW" or footage from lines SW-SW-SW Sec 4-3-59W.  
Lease Owner UNION TEXAS PETROLEUM.  
Lease Name Pollnow Well No. 10  
Office Address 1740 Broadway Suite B-400 Denver, Colo 80202  
Character of Well (completed as Oil, Gas or Dry Hole) Oil  
Date well completed \_\_\_\_\_ 19\_\_\_\_  
Application for plugging filed Sept 12 1966  
Application for plugging approved SEPT 13 1966  
Plugging commenced September 26 1966  
Plugging completed September 27 1966  
Reason for abandonment of well or producing formation \_\_\_\_\_

If a producing well is abandoned, date of last production \_\_\_\_\_ 19\_\_\_\_  
Was permission obtained from the Conservation Division or its agents before plugging was commenced? \_\_\_\_\_

Name of Conservation Agent who supervised plugging of this well W. L. Nichols  
Producing formation \_\_\_\_\_ Depth to top \_\_\_\_\_ Bottom \_\_\_\_\_ Total Depth of Well \_\_\_\_\_ Feet  
Show depth and thickness of all water, oil and gas formations.

OIL, GAS OR WATER RECORDS

CASING RECORD

FORMATION	CONTENT	FROM	TO	SIZE	PUT IN	PULLED OUT

Describe in detail the manner in which the well was plugged, indicating where the mud fluid was placed and the method or methods used in introducing it into the hole. If cement or other plugs were used, state the character of same and depth placed, from \_\_\_\_\_ feet to \_\_\_\_\_ feet for each plug set.

Set rock bridge to 381.0'. Dumped 5 sacks of cement. Shot pipe off at 995.70'. Pulled pipe. Tied into surface pipe with Halliburton and squeezed with 30 sacks of Jel-Mud and then pumped in 75 sacks of cement.

RECEIVED  
STATE CORPORATION COMMISSION

NOV 3 1966

CONSERVATION DIVISION  
WICHITA, KANSAS

11-3-66

(If additional description is necessary, use BACK of this sheet)

Name of Plugging Contractor Bert Self  
Address Hutchinson, Kans.

STATE OF Kansas, COUNTY OF Reno, ss.  
Employee (employee of owner) or (owner or operator) of the above-described well, being first duly sworn on oath, says: That I have knowledge of the facts, statements, and matters herein contained and the log of the above-described well as filed and that the same are true and correct. So help me God.

(Signature) Bert Self  
R. R. #1, Hutchinson, Kans.  
(Address)

SUBSCRIBED AND SWORN TO before me this 19th day of October, 1966

My commission expires October 18, 1969

Notary Public

Oct 26, 1966

FT Morgan, Colorado  
15039-00549-0000

Oil & Gas Commission:

Dear Sirs:

I have lived in Kansas  
most of my life & have worked  
around & operated leases.

I have not heard of all but  
plugging wells however this is fine  
if the state would pay the  
costs or part of them on top of  
that send an invoice of their  
own.

It is ridiculous for an  
individual to recover 1000 of  
Casing & sell it at a good price  
& still lose money on the deal,  
this is just about as near  
dictatorship as you can get.

Please let me know if there  
is some way to recoup part of  
my losses.



P.S. I will print what is sent in a few days