

15-039-00087-00-00

STATE OF KANSAS  
STATE CORPORATION COMMISSION

Give All Information Completely  
Make Required Affidavit  
Mail or Deliver Report to:  
Conservation Division  
State Corporation Commission  
211 No. Broadway  
Wichita, Kansas

WELL PLUGGING RECORD

Decatur County. Sec. 4 Twp. 35 Rge. 29 (E) W (W)

Location as "NE/CNW%SW%" or footage from lines C SE NE

Lease Owner Anderson-Prichard Oil Corporation

Lease Name Lotker Well No. 2

Office Address Liberty Bank Building, Oklahoma City 2, Oklahoma

Character of Well (completed as Oil, Gas or Dry Hole) Dry Hole

Date well completed July 28 1958

Application for plugging filed July 28 1958

Application for plugging approved July 28 1958


Plugging commenced July 28 1958

Plugging completed July 28 1958

Reason for abandonment of well or producing formation Dry Hole

If a producing well is abandoned, date of last production \_\_\_\_\_ 19\_\_\_\_

Was permission obtained from the Conservation Division or its agents before plugging was commenced? Yes

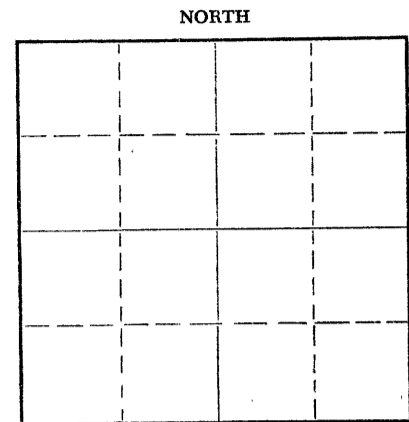

Locate well correctly on above Section Plat

Name of Conservation Agent who supervised plugging of this well A. D. Fabricius, Hill City, Kansas

Producing formation \_\_\_\_\_ Depth to top \_\_\_\_\_ Bottom \_\_\_\_\_ Total Depth of Well 3913 Feet

Show depth and thickness of all water, oil and gas formations.

OIL, GAS OR WATER RECORDS

CASING RECORD

FORMATION	CONTENT	FROM	TO	SIZE	PUT IN	PULLED OUT
		0	226'	8 5/8"	226'	None

Describe in detail the manner in which the well was plugged, indicating where the mud fluid was placed and the method or methods used in introducing it into the hole. If cement or other plugs were used, state the character of same and depth placed, from \_\_\_\_\_ feet to \_\_\_\_\_ feet for each plug set.

From 3913' to 220' - heavy rotary mud  
220' to 157' - plug, 20 sacks cement and 1/2 sack hulls  
157' to 40' - heavy rotary mud  
40' to 6' - plug, 10 sacks cement and 1/2 sack hulls  
6' to 0' - cellar

RECEIVED  
STATE CORPORATION COMMISSION

AUG 1 1958

CONSERVATION DIVISION  
Wichita, Kansas

8-1-58

(If additional description is necessary, use BACK of this sheet)

Name of Plugging Contractor GLENN W. PEEL

Address P.O. Box 359, Hoisington, Kansas

STATE OF KANSAS, COUNTY OF BARTON, ss.  
GLENN W. PEEL (employee of owner) or (owner or operator) of the above-described

well, being first duly sworn on oath, says: That I have knowledge of the facts, statements, and matters herein contained, and the log of the above-described well as filed and that the same are true and correct. So help me God. GLENN W. PEEL

(Signature) BY: [Signature]

P.O. Box 359, Hoisington, Kansas  
(Address)

SUBSCRIBED AND SWORN TO before me this 30th day of July, 19 58

My commission expires April 27, 1960

[Signature]

Notary Public.

PLUGGING  
FILE SEC 4 T 3 290  
BOOK PAGE 119 LINE 27