


STATE OF KANSAS
STATE CORPORATION COMMISSION

15-039-00059-00-00

WELL PLUGGING RECORD

Give All Information Completely
Make Required Affidavit
Mail or Deliver Report to:
Conservation Division
State Corporation Commission
800 Biting Building
Wichita, Kansas

NORTH

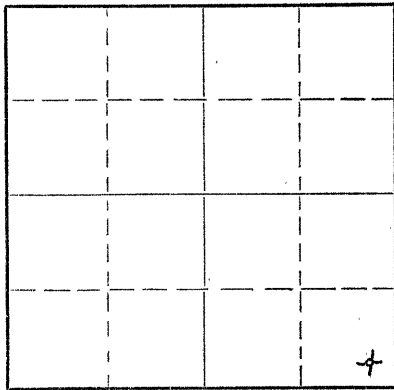

Locate well correctly on above
Section Plat

Decatur County. Sec. 3 Twp. 3S Rge. 29 (E) W (W)

Location as "NE/CNW/SW" or footage from lines SE SE SE

Lease Owner Anderson-Prichard Oil Corporation

Lease Name Nitsch Well No. 1

Office Address Liberty Bank Building, Oklahoma City, Oklahoma

Character of Well (completed as Oil, Gas or Dry Hole) Dry Hole

Date well completed 4-16 1953

Application for plugging filed 4-16 1953

Application for plugging approved 4-16 1953

Plugging commenced 4-16 1953

Plugging completed 4-16 1953

Reason for abandonment of well or producing formation Dry Hole

If a producing well is abandoned, date of last production 19

Was permission obtained from the Conservation Division or its agents before plugging was commenced? Yes

Name of Conservation Agent who supervised plugging of this well Eldon Petty

Producing formation Depth to top Bottom Total Depth of Well 4185 Feet

Show depth and thickness of all water, oil and gas formations.

OIL, GAS OR WATER RECORDS

CASING RECORD

FORMATION	CONTENT	FROM	TO	SIZE	PUT IN	PULLED OUT
		0	190	8 5/8"	190'	None

Describe in detail the manner in which the well was plugged, indicating where the mud fluid was placed and the method or methods used in introducing it into the hole. If cement or other plugs were used, state the character of same and depth placed, from feet to feet for each plug set.

4185' to 186½' - Heavy rotary mud
186½' to 185' - Wooden Plug
185' to 139' - 15 sks, cement & ½ hulls
139' to 46½' - Heavy rotary mud
46½' to 45' - Wooden Plug
45' to 6' - 10 sks, cement & ½ sks, Hulls
6' to Surface - Cellar

RECEIVED
STATE CORPORATION COMMISSION

4-24-53

(If additional description is necessary, use BACK of this sheet)

Name of Plugging Contractor Glenn W. Peel

Address P. O. Box 359, Hoisington, Kansas

STATE OF Kansas, COUNTY OF Barton, ss.
Glenn W. Peel (employee of owner) or (owner or operator) of the above-described

well, being first duly sworn on oath, says: That I have knowledge of the facts, statements, and matters herein contained and the log of the above-described well as filed and that the same are true and correct. So help me God.

(Signature) BY: *Glenn W. Peel*
P. O. Box 359
Hoisington, Kansas
(Address)

SUBSCRIBED AND SWORN TO before me this 21st day of April, 1953

Manian Mc Nerrel
Notary Public.

My commission expires June 4, 1955

