


STATE OF KANSAS
STATE CORPORATION COMMISSION

Give All Information Completely
Make Required Affidavit
Mail or Deliver Report to:
Conservation Division
State Corporation Commission
212 North Market, Insurance Bldg.
Wichita, Kansas

15-039-00119-00-00
WELL PLUGGING RECORD

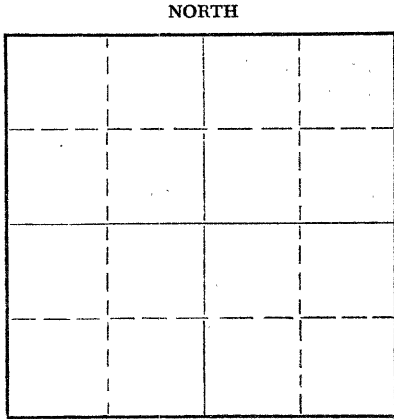

Locate well correctly on above Section Plat

Decatur County, Sec. 36 Twp. 35 Rge. 28 (E) W (W)
Location as "NE/CNW4SW4" or footage from lines C NE SW
Lease Owner Cities Service Petroleum Company
Lease Name Jennings B Well No. 1
Office Address Box 553, Russell, Kansas
Character of Well (completed as Oil, Gas or Dry Hole) Dry Hole
Date well completed 7/6 19 61
Application for plugging filed 7/6 19 61
Application for plugging approved 7/7 19 61
Plugging commenced 7/7 19 61
Plugging completed 7/7 19 61
Reason for abandonment of well or producing formation Non Commercial

If a producing well is abandoned, date of last production _____ 19____
Was permission obtained from the Conservation Division or its agents before plugging was commenced? Yes

Name of Conservation Agent who supervised plugging of this well Eldon Petty, Box 326, Hays, Ks.
Producing formation _____ Depth to top _____ Bottom _____ Total Depth of Well 4360 Feet
Show depth and thickness of all water, oil and gas formations.

OIL, GAS OR WATER RECORDS

CASING RECORD

FORMATION	CONTENT	FROM	TO	SIZE	PUT IN	PULLED OUT
				8-5/8	334'	-0-

Describe in detail the manner in which the well was plugged, indicating where the mud fluid was placed and the method or methods used in introducing it into the hole. If cement or other plugs were used, state the character of same and depth placed, from _____ feet to _____ feet for each plug set.

Filled hole w/heavy mud thru drill pipe from 4360' to 300'.
Set Howco Wooden Plug at 300' - Put 1/4 sack of cotton seed hulls on plug at 300'.
Spotted 20 sx. of reg. cement thru drill pipe on top of plug at 300' to 244'.
Filled hole w/heavy mud 244'-150', thru drill pipe;
pushed 8-5/8 Howco wood plug to 150' - put 1/4 sack hulls on plug at 150'.
Ran 20 sx. cement thru drill pipe; filled 150' to 94'.
Filled hole w/heavy mud 94' to 40'; pushed Howco wood plug to 40'.
Put 1/4 sack hulls and 4' dry soil from 40' to 36' - Ran 10 sx. cement 36' to base of cellar - Ran 1 sack cement in base of cellar - cutt off 8-5/8" casing at base of cellar - Job complete 11 PM 7/7/61.

RECEIVED
STATE CORPORATION COMMISSION

JUL 26 1961

7-26-61

(If additional description is necessary, use BACK of this sheet)
Name of Plugging Contractor Muffin Drilling Company
Address 617 Union Center - Wichita, Kansas

CONSERVATION DIVISION
Wichita, Kansas

STATE OF KANSAS, COUNTY OF BARTON, ss.
M. M. HARDIN (employee of owner) or (owner or operator) of the above-described well, being first duly sworn on oath, says: That I have knowledge of the facts, statements, and matters herein contained and the log of the above-described well as filed and that the same are true and correct. So help me God.

(Signature) *M. M. Hardin*
M. M. Hardin - District Superintendent
Box 553, Russell, Kansas (Address)

SUBSCRIBED AND SWORN TO before me this 19th day of July 1961

My commission expires March 12, 1963

W. J. Smith
Notary Public.



WELL RECORD

15-039-00119-00-00

WILDCAT.....

DISCOVERY.....

POOL.....

COMPANY Cities Service Production Co. WELL # 1 FARM Jennings "B"

LOCATION 1980' North and 1980' East of SW Corner,
Section 36, Township 3, Range 28W.

ELEV. 2864 D.F., 2678 Gr., 2687 R.D. CO. Decatur STATE Kansas

IP. Dry hole. F. and A. July 7, 1961.

PERFS.....

FRAC..... ACID None

T.D. 4360' PBTD..... GRAV/GOR.....

DRLG. COMM. June 26, 1961 COMP. July 7, 1961 CONTRACTOR Murfin Drlg.Co.

CASING RECORD:

8-5/8" at 334' with 250 sacks cement.

FORMATION RECORD:

shale	0-738
shale and sand	2003
lime	2017
shale and lime streaks	2093
anhydrite	2121
shale	2230
red beds	2320
shale and red bed	2407
anhydrite	2442
shale	2552
shale and shells	2825
lime	2867
lime and shale	3010
shale and lime	3307
lime, sandy	3330
lime and shale	3750
lime	3765
lime and shale	3825
shale and lime	3875
lime	3940
shale and lime	4045
lime and shale	4140
lime and sand	4169
shale and sand	4179
sand and shale streaks	4260
chert	4300
lime and shale	4330
lime	4360 T.D.

Slope Tests (Eastman and Geologist):

500'	- 1/2"
982'	- 1/2"
1470'	- 3/4"
2010'	- 1 1/2"
2552'	- 3/4"
2940'	- 3/4"
3194'	- 1"
3750'	- 1"

7-7/8" Rotary hole.

RECEIVED
STATE CORPORATION COMMISSION

JUL 26 1961

CONSERVATION DIVISION
Wichita, Kansas

7-26-61