

15-039-00455-00-00


STATE OF KANSAS
STATE CORPORATION COMMISSION

Give All Information Completely
Make Required Affidavit
Mail or Deliver Report to:
Conservation Division
State Corporation Commission
212 North Market, Insurance Bldg.
Wichita, Kansas

WELL PLUGGING RECORD

Decatur County, Sec. 33 Twp. 3S Rge. ~~28~~ 28 (W)

Location as "NE/CNW/SW" or footage from lines 150' SE of Center NW SW
Lease Owner Halliburton Oil Producing Company
Lease Name Vavroch Well No. 10
Office Address 520 Cameron Building, Oklahoma City, Oklahoma
Character of Well (completed as Oil, Gas or Dry Hole) Dry Hole
Date well completed March 11, 19 62
Application for plugging filed March 11, 19 62
Application for plugging approved March 11, 19 62
Plugging commenced March 11, 19 62
Plugging completed March 12, 19 62
Reason for abandonment of well or producing formation Dry Hole

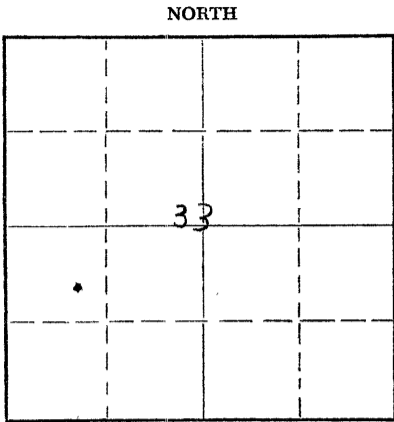

Locate well correctly on above
Section Plat

If a producing well is abandoned, date of last production ----- 19
Was permission obtained from the Conservation Division or its agents before plugging was commenced? Yes

Name of Conservation Agent who supervised plugging of this well Mr. Eldon Petty
Producing formation None Depth to top ----- Bottom ----- Total Depth of Well 3945 Feet
Show depth and thickness of all water, oil and gas formations:

OIL, GAS OR WATER RECORDS

CASING RECORD

FORMATION	CONTENT	FROM	TO	SIZE	PUT IN	PULLED OUT
<u>Lansing</u>	<u>Not Commercial</u>			<u>8 5/8</u>	<u>256'</u>	<u>0</u>

Describe in detail the manner in which the well was plugged, indicating where the mud fluid was placed and the method or methods used in introducing it into the hole. If cement or other plugs were used, state the character of same and depth placed, from ----- feet to ----- feet for each plug set.

Filled hole with heavy mud T.D. to 550'
Placed 20 sack cement plug from 550' to 485'
Filled hole with heavy mud 485' to 240'
Placed 20 sack cement plug from 240' to 180'
Filled hole with heavy mud 180' to 40'
Placed 10 sack cement plug in 8 5/8" casing from 40' to 10'
Cut off surface casing below ground level.

RECEIVED
STATE CORPORATION COMMISSION

APR 6 1962

4-6-62

CONSERVATION DIVISION
Wichita, Kansas

(If additional description is necessary, use BACK of this sheet)

Name of Plugging Contractor Burch Drilling Company
Address Union Center Building, Wichita, Kansas

STATE OF Oklahoma, COUNTY OF Oklahoma, ss.
D. D. Swearingen (employee of owner) or ~~(owner or operator)~~ of the above-described well, being first duly sworn on oath, says: That I have knowledge of the facts, statements, and matters herein contained and the log of the above-described well as filed and that the same are true and correct. So help me God.

(Signature) D. D. Swearingen
520 Cameron Building, Oklahoma City, Okla.
(Address)

SUBSCRIBED AND SWORN TO before me this 4 day of April, 19 62

My commission expires 4-15-62

Marjorie Lockersley
Notary Public.



15-039-00455-00-00

RECEIVED
STATE CORPORATION COMMISSION

CONTRACTOR'S
WELL LOG

APR 6 1962
4-6-62

CONSERVATION DIVISION
Wichita, Kansas

Halliburton Oil Producing Co. &
Burch Drilling Co., Inc.
#10 Vavroch
C NW SW Sec. 33-3S-28W
Decatur County, Kansas

Set 256' 8 5/8" with 250 sacks Posmix
Commenced: 3-3-62
Completed: 3-12-62
Elevation: 2726 KB
D & A

- 2399 Shale
- 2432 Anhydrite
- 2532 Shale
- 2965 Shale & Lime
- 3100 Shale
- 3825 Shale & Lime
- 3877 Lime
- 3945 Shale & Lime
- 3945 Rotary Total Depth

	<u>Tops</u>	
Cim. Anhydrite		2399 (+327)
Lansing		3740 (-1014)

DST #1. 3740-3795. Open 65 minutes shut in 30 minutes. Recovered 3' oil, 143' oil cut mud, 100' slightly oil cut mud. IBHP 1030# (30 mins.), IFP 35#, FFP 123#, FBHP 768# (30 mins).

DST #2. 3787-3825. Open 1 hour shut in 30 minutes. Recovered 2' oil, 33' oil cut mud. IBHP 845# (30 mins.) IFP 18#, FFP 35#, FBHP 523# (30 mins).

STATE OF KANSAS)
COUNTY OF SEDGWICK) ss

I, Earl M. Burch, President of Burch Drilling Co., Inc. being duly sworn on oath, state: That I have knowledge of the facts, statements and matters herein contained and that the same are true and correct.

Earl M. Burch
Earl M. Burch, President

Subscribed and sworn to before me this 26th day of March, 1962.

Minnie E. Matson
Minnie E. Matson, Notary Public

My commission expires: June 18, 1964