

15-039-00495-00-01


STATE OF KANSAS
STATE CORPORATION COMMISSION

Form CP-4

Give All Information Completely
Make Required Affidavit
Mail or Deliver Report to:
Conservation Division
State Corporation Commission
212 No. Market
Wichita, Kansas

WELL PLUGGING RECORD

NORTH

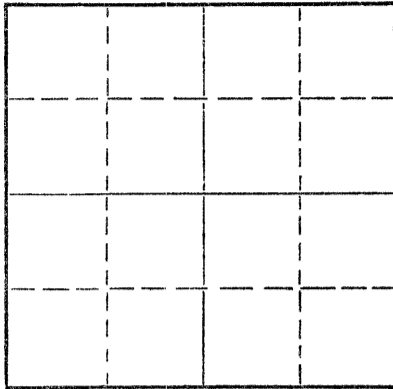

Locate well correctly on above
Section Plat

Decatur County, Sec. 33 Twp. 3S Rge. (E) 28 (W)

Location as "NE/CNW%SW%" or footage from lines C NW SW
Lease Owner Halliburton Oil Producing Company
Lease Name Vavroch Well No. 10
Office Address 2915 Classen Blvd., Okla. City, Okla. 73106
Character of Well (completed as Oil, Gas or Dry Hole) Dry
Date well completed March 25, 1966
Application for plugging filed August 25, 1981
Application for plugging approved August 31, 1981
Plugging commenced August 31, 1981
Plugging completed August 31, 1981
Reason for abandonment of well or producing formation Noncommercial

If a producing well is abandoned, date of last production 19
Was permission obtained from the Conservation Division or its agents before plugging was commenced? Yes

Name of Conservation Agent who supervised plugging of this well Gilbert Balthazor
Producing formation None Depth to top Bottom Total Depth of Well Feet
Show depth and thickness of all water, oil and gas formations.

OIL, GAS OR WATER RECORDS

CASING RECORD

FORMATION	CONTENT	FROM	TO	SIZE	PUT IN	PULLED OUT
K. C. Lansing	Water	3700'	3946'	8-5/8"	256'	None
				4-1/2"	3944'	1383'

Describe in detail the manner in which the well was plugged, indicating where the mud fluid was placed and the method or methods used in introducing it into the hole. If cement or other plugs were used, state the character of same and depth placed, from feet to feet for each plug set.

Pulled 1383' 4-1/2" casing. Plugged as follows:

- 60 sacks cement @ 1260'
- 10 sacks gel 380'-1050'
- 3 sacks cotton seed hulls 380'-240'
- 40 sacks cement 0'-240'

RECEIVED
STATE CORPORATION COMMISSION

SEP 21 1981

CONSERVATION DIVISION
Wichita, Kansas

9-21-81

(If additional description is necessary, use BACK of this sheet)
Name of Plugging Contractor Kelso
Address Box 176, Chase, Kansas 67524

STATE OF OKLAHOMA, COUNTY OF OKLAHOMA, ss.
(employee of owner) or (owner or operator) of the above-described well, being first duly sworn on oath, says: That I have knowledge of the facts, statements, and matters herein contained and the log of the above-described well as filed and that the same are true and correct. So help me God.

(Signature) M. E. Shaw
2915 Classen Blvd., Okla. City, Okla.
(Address)

SUBSCRIBED AND SWORN TO before me this 18th day of September, 1981

My commission expires April 24, 1985 Notary Public.