


15-039-30132-0000

STATE OF KANSAS
STATE CORPORATION COMMISSION

Give All Information Completely
Make Required Affidavit
Mail or Deliver Report to:
Conservation Division
State Corporation Commission
212 North Market, Insurance Bldg.
Wichita, Kansas

WELL PLUGGING RECORD

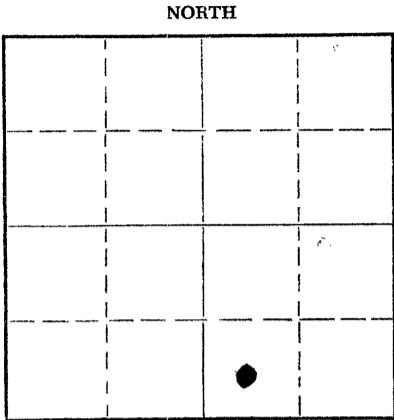

Locate well correctly on above
Section Plat

Decatur County. Sec. 33 Twp. 3S Rge. 28 (~~E~~) (W)
Location as "NE/CNW/SW" or footage from lines C-SW/4 SE /4
Lease Owner Halliburton Oil Producing Co.
Lease Name Vavroch Well No. 3
Office Address 520 Cameron Building - Okla. City 6, Okla.
Character of Well (completed as Oil, Gas or Dry Hole) Dry Hole
Date well completed 8-9 19 60
Application for plugging filed 8-9 19 60
Application for plugging approved 8-9 19 60
Plugging commenced 8-9 19 60
Plugging completed 9a.m. 8-9 19 60
Reason for abandonment of well or producing formation Dry Hole

If a producing well is abandoned, date of last production _____ 19____
Was permission obtained from the Conservation Division or its agents before plugging was commenced? Yes

Name of Conservation Agent who supervised plugging of this well Mr. A. D. Fabricius
Producing formation None Depth to top _____ Bottom _____ Total Depth of Well 3930 Feet
Show depth and thickness of all water, oil and gas formations.

OIL, GAS OR WATER RECORDS

CASING RECORD

FORMATION	CONTENT	FROM	TO	SIZE	PUT IN	PULLED OUT
<u>Lansing</u>	<u>- Not Commercial</u>			<u>8 5/8</u>	<u>217'</u>	<u>None</u>

Describe in detail the manner in which the well was plugged, indicating where the mud fluid was placed and the method or methods used in introducing it into the hole. If cement or other plugs were used, state the character of same and depth placed, from _____ feet to _____ feet for each plug set.

Filled hole with heavy mud from T.D. to 400'
Mixed 20sx. cement and placed in 7 7/8" hole from 400' to 340'
Filled hole with heavy mud from 340' to 215' (inside 8 5/8" casing.)
Mixed 20 sx. cement and placed in 8 5/8" casing from 215' to 155'
Filled hole with heavy mud 155' to 40'
Mixed 10 sx. cement and placed in 8 5/8" casing. 40' to bottom of cellar. Weld plate on top of surface casing.

RECEIVED
STATE CORPORATION COMMISSION

AUG 17 1960

CONSERVATION DIVISION
Wichita, Kansas

(If additional description is necessary, use BACK of this sheet)

Name of Plugging Contractor Burch Drilling Company
Address Wichita, Kansas

STATE OF Oklahoma, COUNTY OF Oklahoma, ss.
D. D. Swearingen (employee of owner) or (owner or operator) of the above-described well, being first duly sworn on oath, says: That I have knowledge of the facts, statements, and matters herein contained and the log of the above-described well as filed and that the same are true and correct. So help me God.

(Signature) D. D. Swearingen
520 Cameron Bldg., Okla. City 6, Okla.

SUBSCRIBED AND SWORN TO before me this 16 day of August, 19 60

My commission expires 4-15-62

Margaret Sauerbeck
Notary Public.

