

KCC

13-039-00452-00-00


Form CP-4

STATE OF KANSAS  
STATE CORPORATION COMMISSION

WELL PLUGGING RECORD

Give All Information Completely  
Make Required Affidavit  
Mail or Deliver Report to:  
Conservation Division  
State Corporation Commission  
211 No. Broadway  
Wichita, Kansas

NORTH

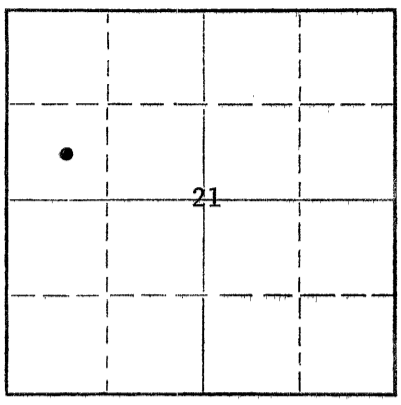

Locate well correctly on above  
Section Plat

Decatur County. Sec. 21 Twp. 3S Rge. (E) 28 (W)  
Location as "NE/CNW/SW" or footage from lines. 150' E. of C SW NW  
Lease Owner Forest Oil Corporation  
Lease Name RUZICKA Well No. 2  
Office Address 1020 Hales Building, Oklahoma City, Oklahoma  
Character of Well (completed as Oil, Gas or Dry Hole) Dry Hole  
Date well completed 7-8-64 19  
Application for plugging filed 7-14-64 19  
Application for plugging approved 7-8-64 (Verbal W.L. Nichols) 19  
Plugging commenced 7-8-64 19  
Plugging completed 7-8-64 19  
Reason for abandonment of well or producing formation Dry Hole

If a producing well is abandoned, date of last production None 19  
Was permission obtained from the Conservation Division or its agents before plugging was commenced? Yes

Name of Conservation Agent who supervised plugging of this well W. L. Nichols  
Producing formation None Depth to top Bottom Total Depth of Well 3918 Feet  
Show depth and thickness of all water, oil and gas formations.

OIL, GAS OR WATER RECORDS

CASING RECORD

FORMATION	CONTENT	FROM	TO	SIZE	PUT IN	PULLED OUT
None				8-5/8"	241'	None

Describe in detail the manner in which the well was plugged, indicating where the mud fluid was placed and the method or methods used in introducing it into the hole. If cement or other plugs were used, state the character of same and depth placed, from feet to feet for each plug set.

Hole was full of rotary mud. As instructed by Mr. Nichols, 20 sax cement were spotted thru drill pipe at 600'; 25 sax spotted thru drill pipe at 240'; 10 sax placed in top of surface casing at the surface.

RECEIVED  
STATE CORPORATION COMMISSION

JUL 21 1964

7-21-64

CONSERVATION DIVISION  
Wichita, Kansas

(If additional description is necessary, use BACK of this sheet)

Name of Plugging Contractor Burch Exploration, Ltd. (Rotary Contractor)  
Address 1011 Union Center Bldg., Wichita, Kansas

STATE OF OKLAHOMA, COUNTY OF OKLAHOMA, ss.  
R. G. Daley (employee of owner) of the above-described well, being first duly sworn on oath, says: That I have knowledge of the facts, statements, and matters herein contained and the log of the above-described well as filed and that the same are true and correct. So help me God.

(Signature) R. G. Daley  
R. G. Daley, Production Superintendent  
Forest Oil Corporation, 1020 Hales Bldg.  
Oklahoma City, Okla. (Address)

SUBSCRIBED AND SWORN TO before me this 16 day of July, 1964

My commission expires 3-15-66. Betty Talley Notary Public.

CONTRACTOR'S  
WELL LOG

Forest Oil Co. #2 Ruzicka  
C SW NW Sec. 21-38-28W  
Decatur County, Kansas

Set 8 5/8" @ 241' with 185 sacks  
Commenced: 7-1-64  
Completed: 7-8-64

D & A

2394 Sand & Shale  
2425 Anhydrite  
2818 Shale & Redbed  
3770 Lime & Shale  
3782 Lime & Chert  
3918 Lime & Shale  
  
3918 Rotary Total Depth

DST #1. 3726-3740. Open 1 hour  
shut in 30 mins. Recovered 1150'  
saltwater. IBHP 1238#; IFF 130#;  
FFP 490#; FBHP 1168#.

DST #2. Packer failure.

DST #3. 3753-3787. Open 5 mins.  
Closed 45 mins. Open 1 hr. closed  
1 hr. Recovered 3' mud. IBHP 1112#;  
IFF 20#; FFP 20W; FBHP 903#.

RECEIVED  
STATE CORPORATION COMMISSION

JUL 21 1964  
7-21-64  
CONSERVATION DIVISION  
Wichita, Kansas

STATE OF KANSAS )  
                              ) ss  
COUNTY OF SEDGWICK )

I, Earl M. Burch, General Partner of Burch Exploration, Ltd. being duly  
sworn on oath, state: That I have knowledge of the facts, statements and  
matters herein contained and that the same are true and correct.

*Earl M. Burch*  
Earl M. Burch, General Partner

Subscribed and sworn to before me this 15th day of July, 1964.

*Minnie E. Matson*  
Minnie E. Matson, Notary Public

My commission expires: June 18, 1968

