


15-039-20256-00-00

STATE OF KANSAS
STATE CORPORATION COMMISSION

Form CP-4

Give All Information Completely
Make Required Affidavit
Mail or Deliver Report to:
Conservation Division
State Corporation Commission
P. O. Box 17027
Wichita, Kansas 67217
NORTH

WELL PLUGGING RECORD

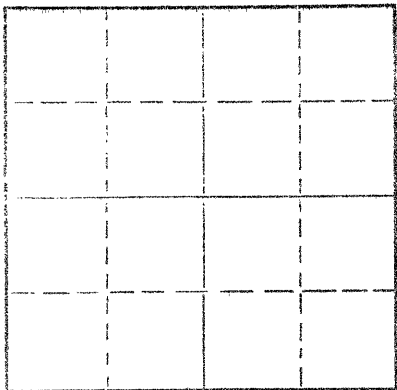

Locate well correctly on above
Section Plat

Decatur County, Sec. 32 Twp. 3S Rge. (E) 28 (W)
Location as "NE/CNW&SW" or footage from lines C NE/4 SE/4
Lease Owner Tomlinson Oil Company
Lease Name TILDEN Well No. 1
Office Address 1030 Olive Garvey Bldg., Wichita, Kansas 67202
Character of Well (completed as Oil, Gas or Dry Hole) Dry Hole
Date well completed January 23, 19 73
Application for plugging filed (verbally) January 23, 19 73
Application for plugging approved (verbally) January 23, 19 73
Plugging commenced January 23, 19 73
Plugging completed January 23, 19 73
Reason for abandonment of well or producing formation Dry Hole

If a producing well is abandoned, date of last production 19
Was permission obtained from the Conservation Division or its agents before plugging was commenced? Yes

Name of Conservation Agent who supervised plugging of this well Bill Nichols
Producing formation Depth to top Bottom Total Depth of Well 3952 Feet
Show depth and thickness of all water, oil and gas formations.

OIL, GAS OR WATER RECORDS

CASING RECORD

FORMATION	CONTENT	FROM	TO	SIZE	PUT IN	PULLED OUT

Describe in detail the manner in which the well was plugged, indicating where the mud fluid was placed and the method or methods used in introducing it into the hole. If cement or other plugs were used, state the character of same and depth placed, from feet to feet for each plug set.

1st plug set at 1625' w/110 cu. ft.
2nd plug set at 275' w/30 cu. ft.
3rd plug set at 40' w/10 cu. ft.
Plug down at 4:00 a.m. 1-23-73.

RECEIVED
STATE CORPORATION COMMISSION
JAN 26 1973
CONSERVATION DIVISION
Wichita, Kansas

1-26-73

(If additional description is necessary, use BACK of this sheet)
Name of Plugging Contractor Abercrombie Drilling, Inc.
Address 801 Union Center, Wichita, Kansas 67202

STATE OF KANSAS COUNTY OF SEDGWICK, ss.
Jerry A. Langrehr (employee of owner) or (owner or operator) of the above-described well, being first duly sworn on oath, says: That I have knowledge of the facts, statements, and matters herein contained and the log of the above-described well as filed and that the same are true and correct. So help me God.

(Signature) Jerry A. Langrehr
801 Union Center, Wichita, Kansas 67202
(Address)

SUBSCRIBED AND SWORN TO before me this 23rd day of January, 19 73

My commission expires February 10, 1975 Beverly Mann Notary Public.

CONTRACTOR'S WELL LOG

OPERATOR: Tomlinson Oil Company
 CONTRACTOR: Abercrombie Drilling, Inc.
 WELL NAME: TILDEN #1
 LOCATION: C NE/4 SE/4, Sec. 32-3S-28W
 Decatur County, Kansas
 GEOLOGIST: Benny C. Singleton, Jr.
 SPUD DATE: January 16, 1973
 COMPLETION DATE: January 23, 1973

0	180	Clay & Sand
180	259	Shale
259	520	Shale & Shells
520	1660	Shale
1660	1880	Sand
1880	2141	Shale
2141	2225	Sand
2225	2418	Shale
2418	2450	Anhydrite
2450	2795	Shale
2795	3790	Lime & Shale
3790	3952	Lime
	3952	Rotary Total Depth

RECEIVED
 STATE CORPORATION COMMISSION
 JAN 26 1973
 CONSERVATION DIVISION
 Wichita, Kansas
 1-26-73

Drilled 259' of 12 $\frac{1}{4}$ " surface hole, set 8-5/8" surface csg. at 258' K.B. w/175 sx. cement. Cement circulated. Plug was down at 9:45 p.m. 1-16-73.
 Dry and Abandoned

<u>SAMPLE TOPS</u>		<u>ELEVATION</u>
Anhydrite	2418 (+ 325)	2743 K.B.
B/Anhydrite	2450 (+ 293)	2742 D.F.
		2736 G.L.

STATE OF KANSAS)
) SS
 COUNTY OF SEDGWICK)

Jerry A. Langrehr, Vice President of Abercrombie Drilling, Inc., does hereby state that the above and foregoing is a true and correct copy of the log of the TILDEN #1, C NE/4 SE/4, Section 32-3S-28W, Decatur County, Kansas.

ABERCROMBIE DRILLING, INC.

By: Jerry A. Langrehr
 Jerry A. Langrehr,
 Vice President

Subscribed and sworn to before me, a Notary Public, in and for the aforesaid county and state as of this 25th day of January, 1973.

Beverly Mann
 Beverly Mann, Notary Public

My Commission Expires:

February 10, 1975