

15-039-20378-00-00


STATE OF KANSAS
STATE CORPORATION COMMISSION

WELL PLUGGING RECORD

Give All Information Completely
Make Required Affidavit
Mail or Deliver Report to
Conservation Division
State Corporation Comm.
245 North Water
Wichita, KS 67202

Decator County. Sec. 28 Twp. 3 Rge. 28 E,
Location as "NE/CNW $\frac{1}{4}$ /SW $\frac{1}{4}$ " or footage from lines _____

NE NE NW
Lease Owner Kelso Casing Pulling
Lease Name Pachner #1 Well No. _____
Office Address Chase, Kansas 67524
Character of Well (Completed as Oil, Gas or Dry Hole) _____

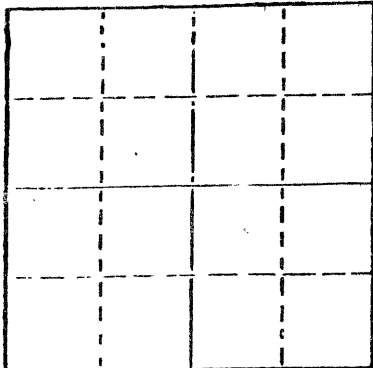

Locate well correctly on above
Section Plat

Date Well completed _____ 19____
Application for plugging filed _____ 19____
Application for plugging approved _____ 19____
Plugging commenced _____ 3/2/79 _____ 19____
Plugging completed _____ 3/9/79 _____ 19____
Reason for abandonment of well or producing formation _____
depleted.

If a producing well is abandoned, date of last production _____ 19____

Was permission obtained from the Conservation Division or
its agents before plugging was commenced? yes

Name of Conservation Agent who supervised plugging of this well Balthazor
Producing formation _____ Depth to top _____ Bottom _____ Total Depth of Well 39
Show depth and thickness of all water, oil and gas formations.

OIL, GAS OR WATER RECORDS

CASING RECORD

FORMATION	CONTENT	FROM	TO	SIZE	PUT IN	PULLED OUT
				8-5/8	280	none
				4 1/2	3933	2232

Describe in detail the manner in which the well was plugged, indicating where the mud fl
was placed and the method or methods used in introducing it into the hold. If cement or oth
plugs were used, state the character of same and depth placed, from _____ feet to
_____ feet for each plug set.

Checked hole, heavy paraffin in hole, pumped 10 gallons gas down hole, couldn't get heavy
weight down. Had to get hot oil tank truck to ehin out paraffin. Shot pipe at 2967', trie
to shoot again and couldn't get down. Allied pushed plug and pumped 15 sacks cement.
Pushed plug to 3500'. Shot pipe at 2745', 2549', 2415', 2296', 2200', pulled pipe. Allied
pumped 70 sacks 50-50 pos, 6%, 23 sacks gel. Released plug and pumped 60 sacks cement.

PLUGGING COMPLETE.

(If additional description is necessary, use BACK of this sheet)

Name of Plugging Contractor KELSO CASING PULLING
CHASE, KANSAS

STATE RECEIVED
CORPORATION COMMISSION

MAR 19 1979

3-19-79
CONSERVATION DIVISION
Wichita, Kansas

STATE OF KANSAS COUNTY OF Rice
R. DARRELL KELSO (employee of owner) or (owner or ope
of the above-described well, being first duly sworn on oath, says: That I have knowledge
the facts, statements, and matters herein contained and the log of the above-described we
as filed and that the same are true and correct. So help me God.

(Signature) R. Darrell Kelso
CHASE, KANSAS
(Address)

SUBSCRIBED AND SWORN TO before me this 15th day of March, 1979

Margaret Melcher
Notary Publ

My commission expires

