


STATE OF KANSAS
STATE CORPORATION COMMISSION

WELL PLUGGING RECORD

Give All Information Completely.
Make Required Affidavit
Mail or Deliver Report to
Conservation Division
State Corporation Comm.
245 North Water
Wichita, KS 67202

DECATUR County. Sec. 28 Twp. 35 Rge. 28 E W
Location as "NE/CNW $\frac{1}{4}$ SW $\frac{1}{4}$ " or footage from lines
SE-NW-NE
Lease Owner RUDY PACHNER/KANSAS OIL CORP.
Lease Name PACHNER Well No. 2
Office Address 400 N. Woodlawn Wichita 67208
Character of Well (Completed as Oil, Gas or Dry Hole) dry hole oil

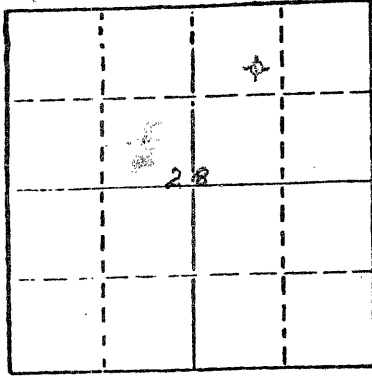

Locate well correctly on above Section Plat

Date Well completed 1976
Application for plugging filed 1977
Application for plugging approved 10-6-1977
Plugging commenced 10-6-1977
Plugging completed 10-17-1977
Reason for abandonment of well or producing formation dry hole
If a producing well is abandoned, date of last production NONE 19
Was permission obtained from the Conservation Division or its agents before plugging was commenced? Yes

Name of Conservation Agent who supervised plugging of this well GILBERT BALTHAZOR
Producing formation KAN. CITY Depth to top 3758 Bottom 3865 Total Depth of Well 3964
Show depth and thickness of all water, oil and gas formations.

OIL, GAS OR WATER RECORDS

CASING RECORD

FORMATION	CONTENT	FROM	TO	SIZE	PUT IN	PULLED OUT
<u>Dakota</u>	<u>WATER</u>	<u>1315</u>	<u>2215</u>	<u>8-5/8</u>	<u>268'</u>	<u>NONE</u>
<u>Tarrant</u>	<u>DRY</u>	<u>3742</u>	<u>3902</u>	<u>4-1/2</u>	<u>3912'</u>	<u>1515'</u>
<u>KANSAS CITY</u>	<u>DRY</u>	<u>3758</u>	<u>3800</u>			

Describe in detail the manner in which the well was plugged, indicating where the mud fluid was placed and the method or methods used in introducing it into the hold. If cement or other plugs were used, state the character of same and depth placed, from feet to feet for each plug set.

Plug back to 3685' w/ sand & gravel.
Pipe shot off @ 1515' and pulled


5 SACKS of balls, 200 SACK of gel, 120 SACK of CEMENT 2550 gal. 10% CALCIUM CHLORIDE, followed by 5 5/8" HALLIBURTON plug, and pumped down to 260'. FIVE SACKS of CEMENT, from 30' to TOP of surface pipe.

(If additional description is necessary, use BACK of this sheet)
Name of Plugging Contractor Pac Well Service and Halliburton
RECEIVED STATE CORPORATION COMMISSION 2-24-78 FEB 24 1978

STATE OF COUNTY OF (employee of owner) or (owner or operator) of the above-described well, being first duly sworn on oath, says: That I have knowledge of the facts, statements, and matters herein contained and the log of the above-described well as filed and that the same are true and correct. So help me God.

(Signature) Floyd C. Wilson
400 N. Woodlawn
(Address)

SUBSCRIBED AND SWORN TO before me this 23 day of February, 1978

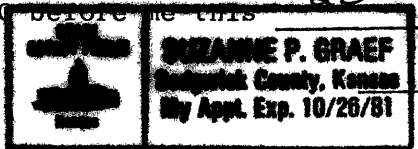

Suzanne P. Graef
Notary Public.

My commission expires