


STATE OF KANSAS
STATE CORPORATION COMMISSION

Give All Information Completely
Make Required Affidavit
Mail or Deliver Report to:
Conservation Division
State Corporation Commission
211 No. Broadway
Wichita, Kansas

15-039-00096-00-00
WELL PLUGGING RECORD

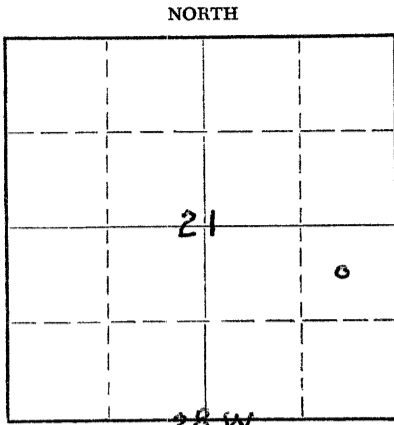

Locate well correctly on above Section Plat

Decatur County, Sec. 21 Twp. 3S Rge. 28 (E) (W)
Location as "NE/CNW%SW%" or footage from lines G NE SE
Lease Owner Sauvage Drilling Co., Inc.
Lease Name Harmon Well No. 1
Office Address Oberlin, Kansas
Character of Well (completed as Oil, Gas or Dry Hole) Dry
Date well completed 8-20-60 19
Application for plugging filed 8-20-60 19
Application for plugging approved 8-20-60 19
Plugging commenced 8-20-60 19
Plugging completed 8-20-60 5 PM 19
Reason for abandonment of well or producing formation Dry

If a producing well is abandoned, date of last production _____ 19
Was permission obtained from the Conservation Division or its agents before plugging was commenced? Yes

Name of Conservation Agent who supervised plugging of this well Al Fabricius - Hill City, Kansas
Producing formation _____ Depth to top _____ Bottom _____ Total Depth of Well 3966 Feet
Show depth and thickness of all water, oil and gas formations.

OIL, GAS OR WATER RECORDS

CASING RECORD

FORMATION	CONTENT	FROM	TO	SIZE	PUT IN	PULLED OUT
Lime & shale				8-5/8"	250	none

Describe in detail the manner in which the well was plugged, indicating where the mud fluid was placed and the method or methods used in introducing it into the hole. If cement or other plugs were used, state the character of same and depth placed, from _____ feet to _____ feet for each plug set.

Filled with heavy mud to 400 feet - set plug with 20 sax cement - filled with mud to 250 feet - set plug with 20 sax cement - filled with mud to 40 feet - set plug with 10 sax cement - fill with mud to bottom of cellar.

RECEIVED
STATE CORPORATION COMMISSION

AUG 24 1960

CONSERVATION DIVISION
Wichita, Kansas

S. 24-60

(If additional description is necessary, use BACK of this sheet)

Name of Plugging Contractor Sauvage Drilling Co., Inc. Co tools
Address Oberlin, Kansas

STATE OF Kansas, COUNTY OF Decatur, ss.
Keith Gallatin (employee of owner) or (owner or operator) of the above-described well, being first duly sworn on oath, says: That I have knowledge of the facts, statements, and matters herein contained and the log of the above-described well as filed and that the same are true and correct. So help me God.

(Signature) Keith Gallatin
Oberlin, Kansas
(Address)

SUBSCRIBED AND SWORN TO before me this 22nd day of August 19 60

My commission expires June 18, 1962
Jarvis Bryans Notary Public.



R

OPERATOR Sauvage Drl'g Co., Inc. LOCATION C NE SE 21-3S-28W
 FARM NAME DECATUR COUNTY, KANSAS
 WELL NO. CASING RECORD:
 250' 8-5/8"
 Surface casing
 CONTRACTOR
 ROTARY COMMENCED TOTAL DEPTH 3966
 ROTARY COMPLETED DRY ELEVATION 2746 KB

Figures denote bottom of formation

Shale & lime	1790
Shale & shells	2020
Gyp	2065
Shale	2128
Gyp - blaine	2142
Lime & shale	2417
Anhydrite	2630
Shale & shell	2830
Shale & pyrite	2955
Broken shale	3000
Shale & shells	3280
Lime & shale	3678
Lime	3796
Shale-lime & chert	3800
Lime	3966 TD

RECEIVED
STATE CORPORATION COMMISSION

AUG 24 1960

CONSERVATION DIVISION
Wichita, Kansas

8-24-60

STATE OF KANSAS)
) SS
 DECATUR COUNTY)

I hereby certify that the foregoing is, to the best of my knowledge and belief, a true and correct drilling log as shown by the drilling reports in connection with the aforesaid well.

Keith Gallatin
 Keith Gallatin, Oberlin, Kansas

Subscribed and sworn to before me, the undersigned, a Notary Public, this 23 day of August, 1960.

Dance Ryan
 Notary Public

My commission expires June 18, 1962