


STATE OF KANSAS
STATE CORPORATION COMMISSION

WELL PLUGGING RECORD

Give All Information Completely
Make Required Affidavit
Mail or Deliver Report to
Conservation Division
State Corporation Comm.
245 North Water
Wichita, KS 67202

Decatur County, Sec. 29 Twp. 3S Rge. 28W XE/W
Location as "NE/CNW $\frac{1}{4}$ SW $\frac{1}{4}$ " or footage from lines
C-NW-SW

Lease Owner Denver Energy Investments
Lease Name Bryan Well No. A-1
Office Address 703 American National Bank Bldg, Denver, CO
Character of Well (Completed as Oil, Gas or Dry Hole)

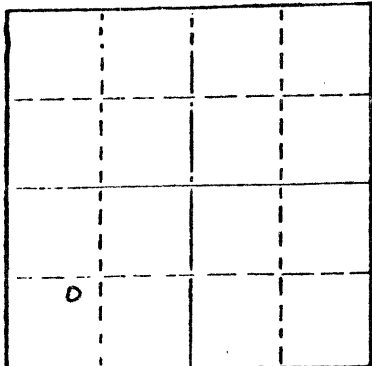

Locate well correctly on above Section Plat

Dry hole
Date Well completed 12-13-1978
Application for plugging filed 12-22-1978
Application for plugging approved 12-22-1978
Plugging commenced 12-22-1978
Plugging completed 12-22-1978
Reason for abandonment of well or producing formation

If a producing well is abandoned, date of last production 19

Was permission obtained from the Conservation Division or its agents before plugging was commenced? yes -verbal

Name of Conservation Agent who supervised plugging of this well Leo Massey
Producing formation Depth to top Bottom Total Depth of Well 3979
Show depth and thickness of all water, oil and gas formations.

OIL, GAS OR WATER RECORDS

CASING RECORD

FORMATION	CONTENT	FROM	TO	SIZE	PUT IN	PULLED OUT
		0	327	8 5/8	294	None

Describe in detail the manner in which the well was plugged, indicating where the mud fluid was placed and the method or methods used in introducing it into the hold. If cement or other plugs were used, state the character of same and depth placed, from feet to feet for each plug set.

Hole filled with drilling mud
70 sack cement plug @ 1200'
20 sack cement plug @ 240'
10 sack cement plug @ 40'
5 sack cement plug in rat hole

(If additional description is necessary, use BACK of this sheet)

Name of Plugging Contractor Tornado Drilling Co., Inc.

STATE OF OKLAHOMA COUNTY OF GARFIELD, ss.
I, Boyd Phillips (employee of owner) or (owner or operator)
of the above-described well, being first duly sworn on oath, says: That I have knowledge of the facts, statements, and matters herein contained and the log of the above-described well as filed and that the same are true and correct. So help me God.

(Signature) Boyd Phillips
P.O. Box 706, Enid, OK 73701
(Address)

SUBSCRIBED AND SWORN TO before me this 29th day of December, 1978

Deborah Allen
Notary Public.

My commission expires Aug. 25, 1982

Rec'd

12-30-78

DRILLERS LOG

Well Name Bryan A#1

Casing Record:

8 5/8" @ 294'
cemented w/225
sack Pozmix

Company Denver Energy Investments

Contractor Tornado Drilling Co., Inc.

Starting Date 12-13-78

Completed Date 12-22-78

Description:

C-NW-SW
29-3S-28W

Total Depth 3979

Elevation Unknown

Formation	From	To	Remarks
Shale	0	327	
Red bed shale	327	1150	
Gray shale	1150	1320	
Shale & sand	1320	2150	
Shale w/lime streaks	2150	2666	- Anhydrite Top @ 2427'
Shale	2666	3015	
Sand & Shale	3015	3394	
Shale & Lime	3394	3945	
Shale	3945	3979	
T.D.		3979	

STATE OF OKLAHOMA)
)
COUNTY OF GARFIELD)

RECEIVED
STATE CORPORATION COMMISSION
MAR 19 1979
3-19-79
CONSERVATION DIVISION
Wichita, Kansas

I do certify that this a true and correct copy of the above log to the best of my knowledge.

TORNADO DRILLING COMPANY, INC.

Boyd D. Phillips
Boyd D. Phillips, President

Subscribed and sworn to before me this 29th day of December, 1979.

Deborah Allen
Notary Public

My Commission Expires: Aug. 25, 1982