

15-039-30063-00-00

Form CP-4

STATE OF KANSAS  
STATE CORPORATION COMMISSION

Give All Information Completely  
Make Required Affidavit  
Mail or Deliver Report to:  
Conservation Division  
State Corporation Commission  
212 No. Market  
Wichita, Kansas

WELL PLUGGING RECORD

Decatur County, Sec. 16 Twp. 3S Rge. 1 (1/2) 28 (W)

Location as "NE/CNW/SW" or footage from lines C SE SW

Lease Owner Halliburton Oil Producing Co.

Lease Name BREMER Well No. 1

Office Address Cameron Building, 2915 Classen Blvd., Okla. City, Okla.

Character of Well (completed as Oil, Gas or Dry Hole) Dry Hole

Date well completed September 14 19 66

Application for plugging filed verbally - September 14 19 66

Application for plugging approved verbally - September 14 19 66


Plugging commenced September 14 19 66

Plugging completed September 14 19 66

Reason for abandonment of well or producing formation Dry

If a producing well is abandoned, date of last production \_\_\_\_\_ 19 \_\_\_\_\_

Was permission obtained from the Conservation Division or its agents before plugging was commenced? Yes

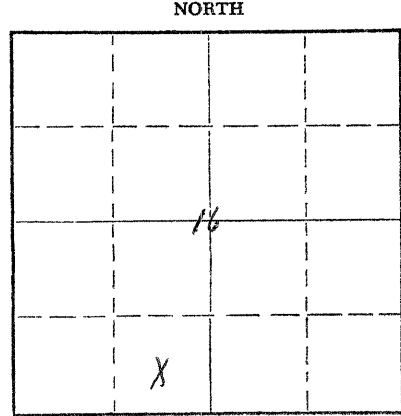

Locate well correctly on above Section Plat

Name of Conservation Agent who supervised plugging of this well W. L. Nichols, Moreland, Kansas

Producing formation \_\_\_\_\_ Depth to top \_\_\_\_\_ Bottom \_\_\_\_\_ Total Depth of Well \_\_\_\_\_ Feet

Show depth and thickness of all water, oil and gas formations.

OIL, GAS OR WATER RECORDS


CASING RECORD

FORMATION	CONTENT	FROM	TO	SIZE	PUT IN	PULLED OUT
				7"	264'	None

Describe in detail the manner in which the well was plugged, indicating where the mud fluid was placed and the method or methods used in introducing it into the hole. If cement or other plugs were used, state the character of same and depth placed, from \_\_\_\_\_ feet to \_\_\_\_\_ feet for each plug set.

Set 1st plug

Filled hole with heavy mud to 600' with 20 sacks cement.  
Filled hole to 270' with heavy mud, set 2nd plug at 270'  
with 15 sacks of cement. Filled hole with heavy mud to 40'  
top plug @ 40' to surface with 10 sacks.

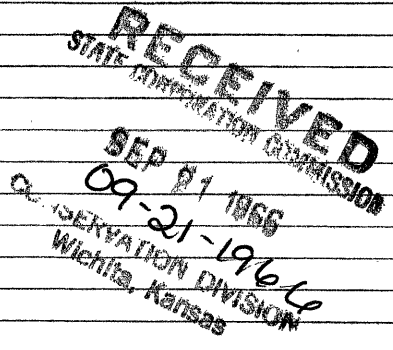

(If additional description is necessary, use BACK of this sheet)

Name of Plugging Contractor Abercrombie Drilling, Inc.

Address 801 Union Center, Wichita

STATE OF KANSAS, COUNTY OF SEDGWICK, ss.  
Jack K. Wharton (employee of owner) or (~~owner or operator~~) of the above-described well, being first duly sworn on oath, says: That I have knowledge of the facts, statements, and matters herein contained and the log of the above-described well as filed and that the same are true and correct. So help me God.

(Signature) Jack K. Wharton

801 Union Center, Wichita, Kansas  
(Address)

SUBSCRIBED AND SWORN TO before me this 20th day of September, 19 66

My commission expires March 31, 1970

Margo Dee Montgomery  
Margo Dee Montgomery Notary Public.

CONTRACTOR'S WELL LOG

15-039-30063-00-00

COMPANY:	Halliburton Oil Producing Company
CONTRACTOR:	Abercrombie Drilling, Inc.
FARM:	BREMER #1
LOCATION:	C SE SW, Section 16-3S-28W Decatur County, Kansas
COMMENCED:	September 8, 1966
COMPLETED:	September 15, 1966

0	275	Shale & Sand Stringers
.275	1875	Shale
1875	2139	Shale & Sand
2139	2411	Shale
2411	2444	Anhydrite
2444	2685	Shale
2685	2960	Shale & Shells
2960	3250	Shale & Lime
3250	3450	Lime & Shale
3450	3565	Lime
3565	3845	Lime & Shale
3845	3930	Shale & Lime
	3930	Rotary Total Depth

**RECEIVED**  
 STATE CORPORATION COMMISSION  
 SEP 21 1966  
 09-21-1966  
 CONSERVATION DIVISION  
 Wichita, Kansas

Set 7" surface casing at 264 feet with 125 sacks of HA-5 cement.


Dry and Abandoned

ELEVATION:


2725 K.B.  
 2724 D.F.  
 2718 G.L.

STATE OF KANSAS        )  
                                   ) SS  
 COUNTY OF SEDGWICK    )

I, Jack K. Wharton, do hereby certify that the above and foregoing is a true and correct copy of the log of the BREMER #1, C SE SW, Section 26-3S-28W, Decatur County, Kansas, as reflected by the files of Abercrombie Drilling, Inc.

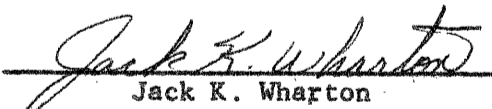  
 Jack K. Wharton

Subscribed and sworn to before me, a Notary Public, in and for Sedgwick County, Kansas, this 19th day of September, 1966.

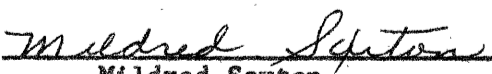  
 Mildred Saxton  
 Notary Public

\*My commission expires October 5, 1968.