


WELL PLUGGING RECORD

Give All Information Completely
Make Required Affidavit
Mail or Deliver Report to:
Conservation Division
State Corporation Commission
211 No. Broadway
Wichita, Kansas

NORTH

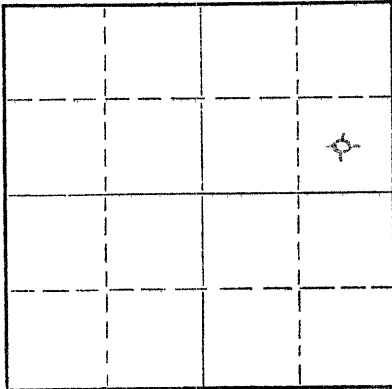

Locate well correctly on above Section Plat

Decatur County, Sec. 18 Twp. 3S Rge. 28 (E) W (W)
Location as "NE/CNW/SW" or footage from lines SE/4 NE/4
Lease ~~Owner~~ Operator: Halliburton Oil Producing Company
Lease Name UNGER "C" Well No. 1
Office Address Cameron Bldg., 2915 Classen Blvd., Okla. City 6, Okla.
Character of Well (completed as Oil, Gas or Dry Hole) Dry Hole
Date well completed September 18, 19 63
Application for plugging filed (verbal) September 18, 19 63
Application for plugging approved (verbal) September 18, 19 63
Plugging commenced September 18, 19 63
Plugging completed September 18, 19 63
Reason for abandonment of well or producing formation _____

If a producing well is abandoned, date of last production _____ 19____
Was permission obtained from the Conservation Division or its agents before plugging was commenced? Yes

Name of Conservation Agent who supervised plugging of this well Bill Nichols
Producing formation _____ Depth to top _____ Bottom _____ Total Depth of Well _____ Feet
Show depth and thickness of all water, oil and gas formations.

OIL, GAS OR WATER RECORDS

CASING RECORD

| FORMATION | CONTENT | FROM | TO | SIZE | PUT IN | PULLED OUT |
|-----------|---------|------|------|--------|--------|------------|
| | | 0 | 266' | 8-5/8" | 266' | none |
| | | | | | | |
| | | | | | | |
| | | | | | | |
| | | | | | | |
| | | | | | | |
| | | | | | | |

Describe in detail the manner in which the well was plugged, indicating where the mud fluid was placed and the method or methods used in introducing it into the hole. If cement or other plugs were used, state the character of same and depth placed, from _____ feet to _____ feet for each plug set.

20 sacks cement mixed and poured through drill pipe on bottom plug set at 540'. 20 sacks on middle plug set at 250'. 10 sacks on top plug set at 40'.

RECEIVED
STATE CORPORATION COMMISSION

SEP 24 1963

09-24-1963

CONSERVATION DIVISION
Wichita, Kansas

(If additional description is necessary, use BACK of this sheet)
Name of Plugging Contractor Birmingham-Bartlett Drilling Co.
Address 300 Kaufman Bldg., Wichita 2, Kansas

STATE OF KANSAS, COUNTY OF SEDGWICK
Richard Hindery, partner of Birmingham-Bartlett Drilling Co., ^{SS} contractor for well, being first duly sworn on oath, says: That I have knowledge of the facts, statements, and matters herein contained and the log of the above-described well as filed and that the same are true and correct. So help me God. BIRMINGHAM-BARTLETT DRILLING CO.

(Signature) By Richard Hindery Partner
300 Kaufman Bldg., Wichita 2, Kansas (Address)

SUBSCRIBED AND SWORN TO before me this 20th day of September, 19 63.

My commission expires October 2, 1966

Beverly Larson
Beverly Larson Notary Public.

15-039-00194-00-00

UNGER "C" NO. 1 WELL

LOCATION: SE/4 NE/4
Section 18-3S-28W
Decatur County, Kansas

SPUDED: 9-10-63
COMPLETION: 9-18-63

OPERATOR: Halliburton Oil Producing Company
Cameron Bldg., 2915 Classen Blvd.
Oklahoma City 6, Oklahoma

CONTRACTOR: Birmingham-Bartlett Drilling Co.
300 Kaufman Bldg.
Wichita 2, Kansas

SURFACE CASING: 8-5/8" 24# casing cemented at 266'
with 190 sacks cement.

OIL STRING: None set. Dry hole. Plugged on 9-18-63.

LOG

(Figures indicate bottom of formation)

| | | |
|-----|------|--------------------|
| 0 - | 25 | Surface clay |
| | 266 | Sand and shale |
| | 1350 | Shale and shells |
| | 1975 | Shale and sand |
| | 2040 | Shale |
| | 2135 | Shale and red bed |
| | 2339 | Shale and shells |
| | 2370 | Anhydrite |
| | 2608 | Shale and shells |
| | 2800 | Shale |
| | 3055 | Shale and shells |
| | 3210 | Lime and shale |
| | 3230 | Shale |
| | 3638 | Lime and shale |
| | 3684 | Lime |
| | 3690 | Cherty lime |
| | 3785 | Lime |
| | 3857 | Lime and shale |
| | 3857 | Rotary total depth |

RECEIVED
STATE CORPORATION COMMISSION

SEP 24 1963

CONSERVATION DIVISION
Wichita, Kansas

The undersigned, Richard Hindery, one of the partners of Birmingham-Bartlett Drilling Co., hereby certifies that the above is a true and correct log of the UNGER "C" NO. 1 WELL as shown in the daily drilling reports.

BIRMINGHAM-BARTLETT DRILLING CO.

By Richard Hindery
Richard Hindery, Partner

Subscribed and sworn to before me
this 20th day of September, 1963.

Beverly Larson
Beverly Larson, Notary Public
My commission expires October 2, 1966.