


STATE OF KANSAS
STATE CORPORATION COMMISSION

15-039-00120-0000

WELL PLUGGING RECORD

Give All Information Completely
Make Required Affidavit
Mail or Deliver Report to:
Conservation Division
State Corporation Commission
211 No. Broadway
Wichita, Kansas

NORTH

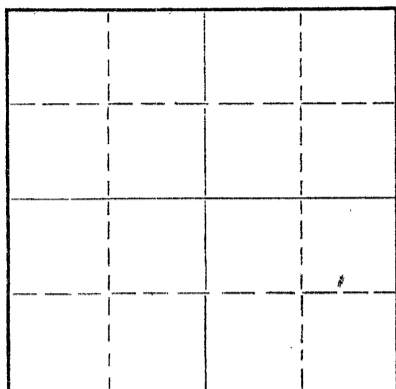

Locate well correctly on above
Section Plat

Decatur County. Sec. 17 Twp. 3 Rge. 28 (E) (W)
Location as "NE/CNW/SW" or footage from lines C NW SE
Lease Owner Empire Drilling Company
Lease Name Ruzicka Well No. 1
Office Address 650-4th National Bank Building, Wichita, Kansas
Character of Well (completed as Oil, Gas or Dry Hole) Dry Hole
Date well completed February 14, 1961 19
Application for plugging filed February 14, 1961 19
Application for plugging approved February 14, 1961 19
Plugging commenced February 14, 1961 19
Plugging completed February 14, 1961 19
Reason for abandonment of well or producing formation Dry Hole

If a producing well is abandoned, date of last production _____ 19____
Was permission obtained from the Conservation Division or its agents before plugging was commenced? yes

Name of Conservation Agent who supervised plugging of this well A. D. Fabricius
Producing formation _____ Depth to top _____ Bottom _____ Total Depth of Well 3860 Feet
Show depth and thickness of all water, oil and gas formations.

OIL, GAS OR WATER RECORDS

CASING RECORD

FORMATION	CONTENT	FROM	TO	SIZE	PUT IN	PULLED OUT
	Sand-Shale	0	171	8 5/8"	158'	-0-

Describe in detail the manner in which the well was plugged, indicating where the mud fluid was placed and the method or methods used in introducing it into the hole. If cement or other plugs were used, state the character of same and depth placed, from _____ feet to _____ feet for each plug set.

Plug set at 400' with 20 sacks cement.
Plug set at 150' with 20 sacks cement.
Plug set at 40' with 10 sacks cement.

RECEIVED
STATE CORPORATION COMMISSION
FEB 22 1961
CONSERVATION DIVISION
Wichita, Kansas
2-22-61

(If additional description is necessary, use BACK of this sheet)

Name of Plugging Contractor Empire Drilling Company
Address 650 Fourth National Bank Building, Wichita 2, Kansas

STATE OF KANSAS, COUNTY OF SEDGWICK, ss.
Theodore Gore (employee or owner) (owner or operator) of the above-described well, being first duly sworn on oath, says: That I have knowledge of the facts, statements, and matters herein contained and the log of the above-described well as filed and that the same are true and correct. So help me God.

(Signature) Theodore Gore
650-4th Nat'l. Bank Bldg., Wichita, Kansas (Address)

SUBSCRIBED AND SWORN TO before me this 17th day of February, 1961

My commission expires June 1, 1963
Joan Gentry Notary Public.



15-039-00120-00-00

LOG

COMPANY: Empire Drilling Company
CONTRACTOR: Empire Drilling Company
FARM: Ruzicka # 1
LOCATION: C NW SE Sec. 17-3-28W, Decatur County, Kansas

COMMENCED: February 6, 1961
COMPLETED: February 13, 1961
ELEVATION: 2642 KB
POTENTIAL: D & A

0	to	171	Sand-Shale
171	to	1230	Shale-Shells
1230	to	1830	Shale-Sand-Shells
1830	to	2119	Shale-Shells
2119	to	2139	Anhydrite
2139	to	2336	Shale-Shells
2336	to	2368	Anhydrite
2368	to	2843	Shale-Shells
2843	to	3200	Shale-Lime
3200	to	3350	Lime-Shale
3350	to	3465	Shale-Lime
3465	to	3685	Lime-Shale
3685	to	3725	Lime
3725	to	3860	Lime-Shale
3860			Rotary Total Depth

SET: 158* 8 5/8" casing with 135 sacks cement.

ELECTRIC LOG TOPS:

Heebner	3606	- 964
Toronto	3634	- 992
Lansing	3645	-1003
Base Kansas City	3849	-1207
Schlumberger TD	3857	

RECEIVED
STATE CORPORATION COMMISSION
FEB 20 1961
CONSERVATION DIVISION
Wichita, Kansas

2-20-61

CERTIFICATION

I, Theodore Gore, do hereby certify that the above and foregoing is a true and correct copy of the log on the Ruzicka # 1, C NW SE Section 17-3-28W, Decatur County, Kansas, as reflected by the files of Empire Drilling Company.

Theodore Gore
THEODORE GORE

Subscribed and sworn to before me, a Notary Public within and for Sedgwick County, Kansas, this 17th day of February, 1961.

Joan Gentry
Joan Gentry, Notary Public

My commission expires June 1, 1963.