

15-039-20-422-00-00


STATE OF KANSAS
STATE CORPORATION COMMISSION

WELL PLUGGING RECORD

Give All Information Completely
Make Required Affidavit
Mail or Deliver Report to
Conservation Division
State Corporation Comm.
245 North Water
Wichita, KS 67202

Decatur County. Sec. 16 Twp. 3S Rge. 28W #/W
Location as "NE/CNW $\frac{1}{4}$ SW $\frac{1}{4}$ " or footage from lines
75' W of NE/4 NW/4 NE/4

Lease Owner Graham-Michaelis Corporation
Lease Name Burns Well No. 1-16
Office Address 211 North Broadway, Wichita, Kansas 67202
Character of Well (Completed as Oil, Gas or Dry Hole) _____

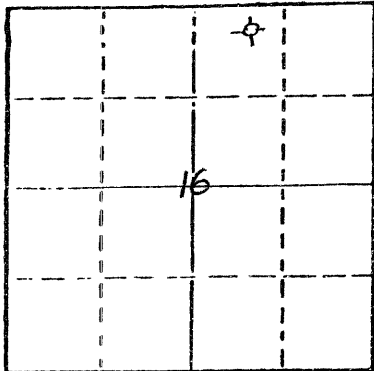

Locate well correctly on above
Section Plat

D & A
Date Well completed July 3, 1978
Application for plugging filed July 4, 1978
Application for plugging approved July 4, 1978
Plugging commenced July 4, 1978
Plugging completed July 4, 1978
Reason for abandonment of well or producing formation _____

D & A
If a producing well is abandoned, date of last production _____ 19__

Was permission obtained from the Conservation Division or its agents before plugging was commenced? Yes

Name of Conservation Agent who supervised plugging of this well Gilbert Balthazor
Producing formation _____ Depth to top _____ Bottom _____ Total Depth of Well 1,005'
Show depth and thickness of all water, oil and gas formations.

OIL, GAS OR WATER RECORDS

CASING RECORD

FORMATION	CONTENT	FROM	TO	SIZE	PUT IN	PULLED OUT
				8 5/8"	276'	-0-

Describe in detail the manner in which the well was plugged, indicating where the mud fluid was placed and the method or methods used in introducing it into the hold. If cement or other plugs were used, state the character of same and depth placed, from _____ feet to _____ feet for each plug set.

Plug #1 @ 1,400' w/70 sx cement
Plug #2 @ 240' w/20 sx cement
Plug #3 @ 40' w/10 sx cement
(Cement was 50-50 Pozmix, 6%)

RECEIVED
STATE CORPORATION COMMISSION

JUL 12 1978
07-12-1978
CONSERVATION DIVISION
Wichita, Kansas

(If additional description is necessary, use BACK of this sheet)

Name of Plugging Contractor Red Tiger Drilling Company
1720 KSB&T Building, Wichita, Kansas 67202


STATE OF Kansas COUNTY OF Sedgwick, ss. contractor
Gloria Fawcett (employee of ~~xxxxxxx~~)
of the above-described well, being first duly sworn on oath, says: That I have knowledge of the facts, statements, and matters herein contained and the log of the above-described well as filed and that the same are true and correct. So help me God.

(Signature) Gloria Fawcett
1720 KSB&T Building, Wichita, Kansas 67202
(Address)

SUBSCRIBED AND SWORN TO before me this 10th day of July, 1978.

Joyce A. Hagermann
Notary Public.

My commission expires _____

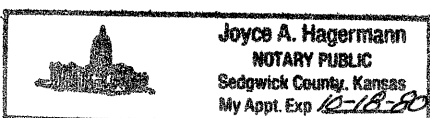

DRILLERS LOG

15-039-20422-0000

No. 1-16 Burns

CASING RECORD:

COMPANY: Graham-Michaelis Corporation

DESCRIPTION:

8 5/8" @ 283'
w/200 sx cement

CONTRACTOR: Red Tiger Drilling Company

75' W of NE/4 NW/4 NE/4
Sec. 16-T3S-R28W
Decatur County, Kansas

COMMENCED: June 27, 1978

COMPLETED: July 4, 1978

TOTAL DEPTH: 4,005'

ELEVATION: 2,707' KB

FORMATION

FROM

TO

REMARKS

Shale	0	1395	
Shale, Sand & Shale	1395	2095	
Shale & Red Bed	2095	2413	
Anhydrite	2413	2444	
Shale	2444	2475	
Shale w/Lime Streaks	2475	2940	
Shale & Lime	2940	3156	
Lime	3156	4005	
RTD		4005	


I certify that this is a true and correct copy of the above log to the best of my knowledge.

RED TIGER DRILLING COMPANY

Gloria Fawcett
Gloria Fawcett

Subscribed and sworn to before me this 10th day of July, 1978.

Joyce A. Hagermann
Notary Public

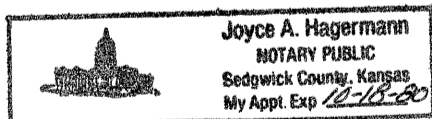

RECEIVED
STATE CORPORATION COMMISSION

JUL 12 1978

CONSERVATION DIVISION
Wichita, Kansas