


Give All Information Completely
Make Required Affidavit
Mail or Deliver Report to:
Conservation Division
State Corporation Commission
211 No. Broadway
Wichita, Kansas

WELL PLUGGING RECORD

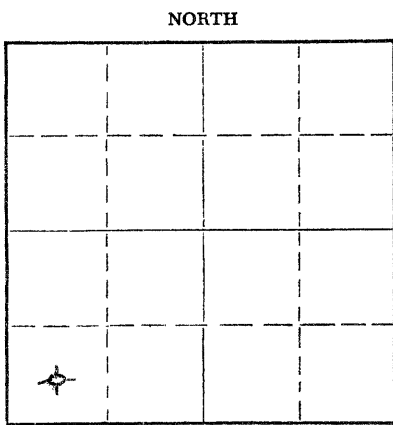

Locate well correctly on above
Section Plat

Decatur County, Sec. 8 Twp. 3S Rge. 28 (E) W (W)

Location as "NE/CNW&SW" or footage from lines Center SW/4 SW/4
Lease Owner Birmingham-Bartlett Drilling Co.
Lease Name MORRISON Well No. 1
Office Address 300 Kaufman Bldg., Wichita2, Kansas
Character of Well (completed as Oil, Gas or Dry Hole) Dry Hole
Date well completed December 14, 19 62
Application for plugging filed (Verbal) December 14, 19 62
Application for plugging approved (Verbal) December 14, 19 62
Plugging commenced December 14, 19 62
Plugging completed December 14, 19 62
Reason for abandonment of well or producing formation Dry Hole

If a producing well is abandoned, date of last production _____ 19____
Was permission obtained from the Conservation Division or its agents before plugging was commenced? Yes

Name of Conservation Agent who supervised plugging of this well Eldon Petty
Producing formation _____ Depth to top _____ Bottom _____ Total Depth of Well 3900 Feet
Show depth and thickness of all water, oil and gas formations.

OIL, GAS OR WATER RECORDS

CASING RECORD

FORMATION	CONTENT	FROM	TO	SIZE	PUT IN	PULLED OUT
		0	272'	8-5/8"	272'	none

Describe in detail the manner in which the well was plugged, indicating where the mud fluid was placed and the method or methods used in introducing it into the hole. If cement or other plugs were used, state the character of same and depth placed, from _____ feet to _____ feet for each plug set.

Bottom plug set at 550' with 20 sacks cement mixed and poured through drill pipe. Middle plug set at 240' with 20 sacks cement mixed and poured through pipe. Top plug set at 35' with 8 sacks cement. 2 sacks cement in rat hole.

RECEIVED
STATE CORPORATION COMMISSION
DEC 19 1962
12-19-1962
CONSERVATION DIVISION
WICHITA, KANSAS

(If additional description is necessary, use BACK of this sheet)
Name of Plugging Contractor Birmingham-Bartlett Drilling Co.
Address 300 Kaufman Bldg., Wichita 2, Kansas

STATE OF KANSAS, COUNTY OF SEDGWICK
Richard Hindery, Partner of Birmingham-Bartlett Drilling Co, owner, Operator & contractor
(employee of owner) or (owner or operator) of the above-described well, being first duly sworn on oath, says: That I have knowledge of the facts, statements, and matters herein contained and the log of the above-described well as filed and that the same are true and correct. So help me God. BIRMINGHAM-BARTLETT DRILLING CO.

(Signature) By Richard Hindery Partner
300 Kaufman Bldg., Wichita 2, Kansas
(Address)

SUBSCRIBED AND SWORN to before me this 18th day of December, 19 62.

My commission expires October 2, 1966.
Beverly Larson
Beverly Larson Notary Public.



15-039-00188-00-00

MORRISON NO. 1 WELL

LOCATION: Center of SW/4 SW/4 Section 8-38-28W Decatur County, Kansas
SPUDDED: 12-6-62
COMPLETED: 12-14-62

OWNER, OPERATOR and CONTRACTOR: Birmingham-Bartlett Drilling Co. 300 Kaufman Building Wichita 2, Kansas

SURFACE CASING: 8-5/8" casing cemented at 272' with 190 sacks cement

OIL STRING: None set. Dry Hole. Plugged on 12-14-62

LOG

(Figures indicate bottom of formation)

0 - 30	Surface clay
1200	Shale and shells
1435	Post rock and shale
1650	Sand
2050	Shale and shells
2210	Shale and red bed
2373	Shale and shells
2408	Anhydrite
2700	Shale and shells
2895	Shale and lime
3170	Shale and shells
3689	Shale and lime
3730	Lime
3775	Shale and lime
3815	Lime
3872	Lime and shale
3985	Lime
3900	Lime and shale
3900	ROTARY TOTAL DEPTH

DEC 10 1962

CONSERV.

The undersigned, Richard Hindery, one of the partners of Birmingham-Bartlett Drilling Co., hereby certifies that the above is a true and correct log of the formations encountered in drilling the Morrison No. 1 Well as shown in the daily drilling reports.

BIRMINGHAM-BARTLETT DRILLING CO.

By Richard Hindery
Richard Hindery, Partner

Subscribed and sworn to before me
this 18th day of December, 1962.

Beverly Larson

Beverly Larson, Notary Public
My commission expires October 2, 1966.