

STATE OF KANSAS
STATE CORPORATION COMMISSION


15-039-20224-00-00

Form CP-4

WELL PLUGGING RECORD

Give All Information Completely
Make Required Affidavit
Mail or Deliver Report to:
Conservation Division
State Corporation Commission
212 No. Market
Wichita, Kansas 67202

NORTH

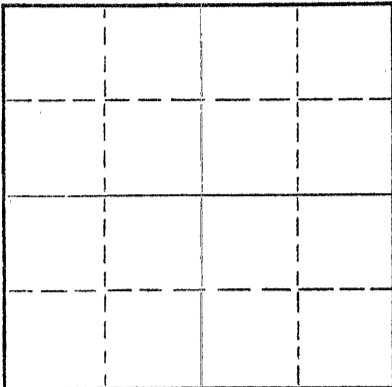

Locate well correctly on above
Section Plat

Decatur County. Sec. 16 Twp. 3S Rge. (E)28 (W)
Location as "NE/CNW%SW%" or footage from lines C SW NW
Lease Owner Abercrombie Drilling, Inc.
Lease Name BREMER Well No. 1
Office Address 801 Union Center, Wichita, Kansas 67202
Character of Well (completed as Oil, Gas or Dry Hole) Dry Hole
Date well completed January 6, 19 72
Application for plugging filed January 6, 19 72
Application for plugging approved January 6, 19 72
Plugging commenced January 6, 19 72
Plugging completed January 6, 19 72
Reason for abandonment of well or producing formation Dry Hole

If a producing well is abandoned, date of last production 19
Was permission obtained from the Conservation Division or its agents before plugging was commenced? Yes

Name of Conservation Agent who supervised plugging of this well Bill Nichols
Producing formation _____ Depth to top _____ Bottom _____ Total Depth of Well 3954 Feet
Show depth and thickness of all water, oil and gas formations.

OIL, GAS OR WATER RECORDS

CASING RECORD

| FORMATION | CONTENT | FROM | TO | SIZE | PUT IN | PULLED OUT |
|-----------|---------|------|----|------|--------|------------|
| | | | | | | |
| | | | | | | |
Describe in detail the manner in which the well was plugged, indicating where the mud fluid was placed and the method or methods used in introducing it into the hole. If cement or other plugs were used, state the character of same and depth placed, from _____ feet to _____ feet for each plug set.

1st plug set at 1575' w/75 sx.
2nd plug set at 245' w/25 sx.
Top plug set at 40' w/10 sx.
Job completed at 10:00 a.m. 1-6-72.

RECEIVED
STATE CORPORATION COMMISSION
01-10-1972
JAN 10 1972
CONSERVATION DIVISION
Wichita, Kansas

(If additional description is necessary, use BACK of this sheet)

Name of Plugging Contractor Abercrombie Drilling, Inc.
Address 801 Union Center, Wichita, Kansas 67202

STATE OF KANSAS, COUNTY OF SEDGWICK, ss.
Jerry A. Langrehr (employee of owner) or (owner or operator) of the above-described well, being first duly sworn on oath, says: That I have knowledge of the facts, statements, and matters herein contained and the log of the above-described well as filed and that the same are true and correct. So help me God.

(Signature) Jerry A. Langrehr
801 Union Center, Wichita, Kansas 67202
(Address)

SUBSCRIBED AND SWORN TO before me this 7th day of January, 1972

My commission expires February 10, 1975

Beverly Mann
Beverly Mann Notary Public.

CONTRACTOR'S WELL LOG

15-039-20224-00-00

OPERATOR: Abercrombie Drilling, Inc.
 CONTRACTOR: Abercrombie Drilling, Inc.
 WELL NAME: BREMER #1
 LOCATION: C SW NW, Sec. 16-3S-28W
 Decatur County, Kansas
 GEOLOGIST: Jack K. Wharton
 SPUD DATE: December 31, 1971
 COMPLETION DATE: January 6, 1972

| | | |
|------|------|----------------------|
| 0 | 180 | Sand & Clay |
| 180 | 230 | Shale |
| 230 | 815 | Shale & Shells |
| 815 | 970 | Sand |
| 970 | 1200 | Shale |
| 1200 | 1770 | Shale w/sand streaks |
| 1770 | 1980 | Sand |
| 1980 | 2413 | Shale |
| 2413 | 2445 | Anhydrite |
| 2445 | 2817 | Shale |
| 2817 | 3108 | Lime & Shale |
| 3108 | 3263 | Shale & Lime |
| 3263 | 3460 | Lime & Shale |
| 3460 | 3954 | Lime |
| | 3954 | Rotary Total Depth |

Set 8-5/8" surface casing at 220' G.L. w/175 sx. Sunset cement. Cement circulated.
 Plus was down at 1:30 a.m. 12-31-71.
 Dry and Abandoned

| ELECTRIC LOG TOPS | | ELEVATION |
|-------------------|--------------|-----------|
| Anhydrite | 2415 (+ 310) | 2725 K.B. |
| B/Anhydrite | 2447 (+ 278) | 2723 D.F. |
| Heebner | 3694 (- 969) | 2717 G.L. |
| Toronto | 3725 (-1000) | |
| Lansing | 3735 (-1010) | |
| ELTD | 3956 (-1231) | |

RECEIVED
 STATE CORPORATION COMMISSION
 JAN 10 1972
 CONSERVATION DIVISION
 Wichita, Kansas

STATE OF KANSAS)
) SS
 COUNTY OF SEDGWICK)

Jerry A. Langrehr, President of Abercrombie Drilling, Inc., does hereby state that the above and foregoing is a true and correct copy of the log of the BREMER #1, C SW NW, Section 16-3S-28W, Decatur County, Kansas.

ABERCROMBIE DRILLING, INC.

By: Jerry A. Langrehr
 Jerry A. Langrehr
 President

Subscribed and sworn to before me, a Notary Public, in and for the aforesaid county and state as of this 7th day of January, 1972.

Beverly Mann
 Beverly Mann, Notary Public

My Commission Expires:

February 10, 1975