


WELL PLUGGING RECORD

Give All Information Completely
Make Required Affidavit
Mail or Deliver Report to:
Conservation Division
State Corporation Commission
211 No. Broadway
Wichita, Kansas

NORTH

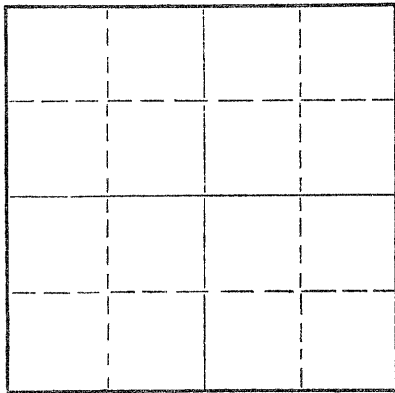

Locate well correctly on above
Section Flat

Decatur County. Sec. 16 Twp. 35 Rge. 28W (E)____(W)
Location as "NE/CNW/SW" or footage from lines C/SW SW
Lease Owner Keith F. Walker Oil Producer
Lease Name BREMER Well No. One
Office Address Box 1783 - Ardmore, Oklahoma
Character of Well (completed as Oil, Gas or Dry Hole) Dry Hole
Date well completed 3/8/62 19____
Application for plugging filed 3/8/62 19____
Application for plugging approved 3/8/62 19____
Plugging commenced 3/8/62 19____
Plugging completed 3/8/62 19____
Reason for abandonment of well or producing formation _____

If a producing well is abandoned, date of last production _____ 19____
Was permission obtained from the Conservation Division or its agents before plugging was commenced? Yes

Name of Conservation Agent who supervised plugging of this well Eldon Petty - Hays, Kansas
Producing formation _____ Depth to top _____ Bottom _____ Total Depth of Well 3907' Feet
Show depth and thickness of all water, oil and gas formations.

OIL, GAS OR WATER RECORDS

CASING RECORD

FORMATION	CONTENT	FROM	TO	SIZE	PUT IN	PULLED OUT
				<u>8 5/8"</u>	<u>396'</u>	<u>None</u>

Describe in detail the manner in which the well was plugged, indicating where the mud fluid was placed and the method or methods used in introducing it into the hole. If cement or other plugs were used, state the character of same and depth placed, from _____ feet to _____ feet for each plug set.

Set plug @ 540' and mixed and displaced 20 sacks cement through Drill Pipe. Set plug @ 180', mixed and displaced 20 sacks cement through Drill Pipe. Set plug @ 35", mixed 10 sacks cement.

RECEIVED
STATE CORPORATION COMMISSION
04-04-1962
APR 4 1962
CONSERVATION DIVISION
Wichita, Kansas

(If additional description is necessary, use BACK of this sheet)
Name of Plugging Contractor Murfin Drilling Company
Address 617 Union Center Building - Wichita 2, Kansas

STATE OF Kansas COUNTY OF Decatur ss.
Robert G. Lovell (employee of owner) or (owner or operator) of the above-described well, being first duly sworn on oath, says: That I have knowledge of the facts, statements, and matters herein contained and the log of the above-described well as filed and that the same are true and correct. So help me God.

(Signature) [Signature]
Box 51, Shawnee, Kansas (Address)

SUBSCRIBED AND SWORN TO before me this 2nd day of April, 1962
E. E. Basler
Notary Public.

My commission expires 3-12-66



WELL LOG

15-D39-00003-00-00


COMPANY Keith F. Walker Oil Producers

SEC. 16 T. 35 R. 28W
LOC. C/5W SW

FARM BREMER NO. One

TOTAL DEPTH 3907'
COMM. 3/2/62 COMP. 3/8/62
SHOT OR TREATED No
CONTRACTOR Murfin Drilling Company
ISSUED

COUNTRY Decatur
KANSAS

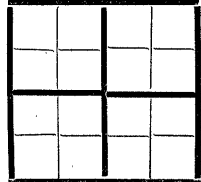

CASING
20 10
15 8 5/8" 206' with 200 sacks cement
12 6
13 5

ELEVATION 2696' KB

PRODUCTION D & A

FIGURES INDICATE BOTTOM OF FORMATIONS

180' Sand-Clay
210' Blue Shale
1190' Shale
1850' Shale & Sand
2095' Sand - Shale
2375' Shale - Sand
2586' Red Bed
2418' Anhydrite
2605' Shale & Sand
2780' Shale-Sand-Lime
2850' Shale-Lime
3375' Lime - Shale
3520' Shale - Lime
3665' Lime - Shale
3730' Lime
3810' Lime & Shale
3907' Lime
3907' Total Depth

ELECTRIC LOG TOPS:

Severy 3522'
Topeka 3550'
Hoebner 3666'
Toronto 3698'
Lansing/Kansas City 3710'
Base/Kansas City 3906'
Total Depth 3907'

3710
2696
1014

DST - NONE

RECEIVED
STATE CORPORATION COMMISSION
04-04-1962
APR 4 1962
CONSERVATION DIVISION
Wichita, Kansas

State of Kansas }
County of Decatur } ss:

I, Robert C. Lowllyn of the Keith F. Walker Company

upon oath state that the above and foregoing is a true and correct copy of the log of the No. 1 Bremer well.

Robert C. Lowllyn

Subscribed and sworn to before me this 2nd day of April 1962

My Commission Expires: 3-12-66

G. E. Rosler
NOTARY PUBLIC