


WELL PLUGGING RECORD

Give All Information Completely
Make Required Affidavit
Mail or Deliver Report to:
Conservation Division
State Corporation Commission
212 No. Market
Wichita, Kansas

NORTH

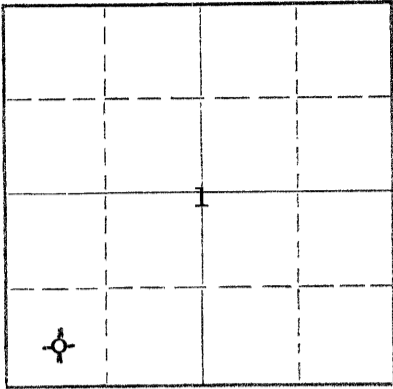

Locate well correctly on above
Section Plat

Decatur County. Sec. 1 Twp. 3S Rge. (E) 28 (W)

Location as "NE/CNW&SW" or footage from lines C SW SW

Lease Owner Rains & Williamson Oil Co., Inc.

Lease Name RHOMINE SMITH Well No. 1

Office Address 1425 Wichita Plaza - Wichita, Kansas

Character of Well (completed as Oil, Gas or Dry Hole) Dry Hole

Date well completed 5-5 19 58⁶⁸

Application for plugging filed 5-5 19 68

Application for plugging approved 5-5 19 68

Plugging commenced 5-5 19 68

Plugging completed 5-5 19 58⁶⁸

Reason for abandonment of well or producing formation No oil or gas found
in commercial quantities.

If a producing well is abandoned, date of last production -- 19 --

Was permission obtained from the Conservation Division or its agents before plugging was commenced? Yes

Name of Conservation Agent who supervised plugging of this well Bill Nichols, Moreland, Kansas

Producing formation -- Depth to top -- Bottom -- Total Depth of Well 3970 Feet

Show depth and thickness of all water, oil and gas formations.

OIL, GAS OR WATER RECORDS

CASING RECORD

FORMATION	CONTENT	FROM	TO	SIZE	PUT IN	PULLED OUT
				8-5/8"	242'	-0-

Describe in detail the manner in which the well was plugged, indicating where the mud fluid was placed and the method or methods used in introducing it into the hole. If cement or other plugs were used, state the character of same and depth placed, from _____ feet to _____ feet for each plug set.

Spotted 100 sacks 50-50 pozmix cement at 1435'. Mudded back to 270' and spotted 20 sacks same. Mudded back to 40' set solid bridge and capped with 10 sacks. Plugging completed at 4:45 PM 5-5-68.

RECEIVED
STATE CORPORATION COMMISSION
MAY 15 1968
CONSERVATION DIVISION
Wichita, Kansas

(If additional description is necessary, use BACK of this sheet)

Name of Plugging Contractor Rains & Williamson Oil Co., Inc.

Address 1425 Wichita Plaza - Wichita, Kansas

STATE OF KANSAS, COUNTY OF SEDGWICK, ss.

Wilson Rains

~~employee of~~ (owner or operator) of the above-described

well, being first duly sworn on oath, says: That I have knowledge of the facts, statements, and matters herein contained and the log of the above-described well as filed and that the same are true and correct. So help me God.

(Signature) Wilson Rains Wilson Rains

1425 Wichita Plaza - Wichita, Kansas

(Address)

SUBSCRIBED AND SWORN TO before me this 13 day of May, 19 68

My commission expires June 30, 1971

Sherry Gish

Notary Public.

ROTARY DRILLING LOG

Operator: Rains & Williamson
Oil Co., Inc.
RHOMINE SMITH #1
C SW SW Sec. 1-3S-28W
Decatur County, Kansas

Contractor: Rains & Williamson
Oil Co., Inc.
Commenced: 4-29-68
Completed: 5-5-68

Remarks: Set 8-5/8" surface casing at 242' w/ 160 sacks cement.

15-039-20043-00-00

Formations

Surface Clay and Shale	125'
Sand	135'
Shale	1990'
Shale and Lime	2322'
Shale	2389'
Anhydrite	2422'
Shale and Lime	3470'
Lime	3970'
Rotary Total Depth (D & A)	3970'

RECEIVED
STATE CORPORATION COMMISSION
05-15-1968
MAY 15 1968
CONSERVATION DIVISION
Wichita, Kansas


We certify the above log is true and correct to the best of our knowledge and belief.

RAINS & WILLIAMSON OIL CO., INC.



Wilson Rains

Subscribed and sworn to before me, a Notary Public within and for the State of Kansas, County of Sedgwick, this 13th day of May, 1968.

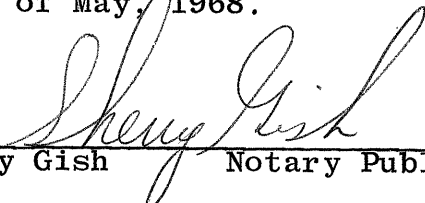

Sherry Gish Notary Public

My Commission Expires:
June 30, 1971