


15-039-00095-00-00

WELL PLUGGING RECORD

Give All Information Completely
Make Required Affidavit
Mail or Deliver Report to:
Conservation Division
State Corporation Commission
800 Bitting Building
Wichita, Kansas

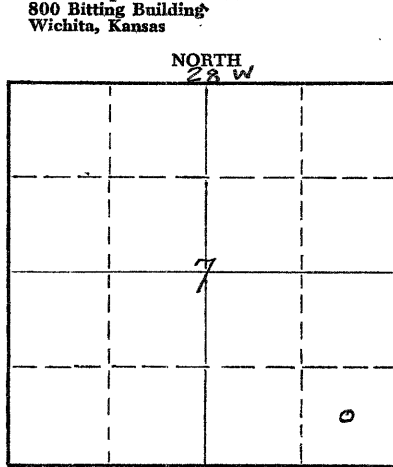

Locate well correctly on above Section Plat

Decatur County. Sec. 7 Twp. 3S Rge. 28W (E) (W)
Location as "NE/CNW/SW" or footage from lines C SE SE
Lease Owner Sauvage Drilling Co., Inc.
Lease Name Shaw Well No. 1
Office Address Oberlin, Kansas
Character of Well (completed as Oil, Gas or Dry Hole) Dry Hole
Date well completed 9-4-60 19
Application for plugging filed 9-4-60 19
Application for plugging approved 9-4-60 19
Plugging commenced 9-4-60 19
Plugging completed 9-4-60 19
Reason for abandonment of well or producing formation Dry

If a producing well is abandoned, date of last production _____ 19
Was permission obtained from the Conservation Division or its agents before plugging was commenced? Yes

Name of Conservation Agent who supervised plugging of this well Al Fabricius, Hill City, Kansas
Producing formation _____ Depth to top _____ Bottom _____ Total Depth of Well 3865 Feet
Show depth and thickness of all water, oil and gas formations.

OIL, GAS OR WATER RECORDS

CASING RECORD

FORMATION	CONTENT	FROM	TO	SIZE	PUT IN	PULLED OUT
	Surface casing	surfact	150	8-5/8"	150	none

Describe in detail the manner in which the well was plugged, indicating where the mud fluid was placed and the method or methods used in introducing it into the hole. If cement or other plugs were used, state the character of same and depth placed, from _____ feet to _____ feet for each plug set.

Filled with mud to 425 feet - set plug with 20 sax cement - filled with mud to 250 feet - set plug with 20 sax cement - filled with mud to 40 feet - set plug with 10 sax cement and fill with mud to bottom of cellar.

RECEIVED
STATE CORPORATION COMMISSION

SEP 14 1960
09-14-1960
CONSERVATION DIVISION
Wichita, Kansas

(If additional description is necessary, use BACK of this sheet)
Name of Plugging Contractor Sauvage Drilling Co., Inc. (Co tools)
Address Oberlin, Kansas

STATE OF Kansas, COUNTY OF Decatur, ss.
Keith Gallatin (employee of owner) or (owner or operator) of the above-described well, being first duly sworn on oath, says: That I have knowledge of the facts, statements, and matters herein contained and the log of the above-described well as filed and that the same are true and correct. So help me God.

(Signature) Keith Gallatin
Keith Gallatin
Oberlin, Kansas
(Address)

SUBSCRIBED AND SWORN TO before me this 7th day of September, 19 60

My commission expires June 18, 1962

Janice Bryan
Notary Public.



Rp

15-039-00095-00-00

OPERATOR	Sauvage Drl'g Co., Inc.	LOCATION	C SE SE 7-3S-28W
FARM NAME	Shaw		Decatur County, Kansas
WELL NO.	1		
CONTRACTOR	Company tools	Casing record:	
ROTARY COMM.	8-28-60		150' of 8-5/8" Sur Casing
ROTARY COMP.	9-4-60		Total Depth 3865

Elevation 2746 K B

Figures denote bottom of formation

Shale	935
Pyrite	949
Shale & shells	1485
Shale & pyrite	2110
Shale	2162
Shale & pyrite	2330
Shale	2343
Anhydrite	2376
Shale & shells w/ pyrite & gyp	2780
Shale & lime	3865 TD

STATE OF KANSAS
 SEP 14 1960
 COMMISSION
 CONSERVATION DIVISION
 Wichita, Kansas

STATE OF KANSAS)
)SS
 DECATUR COUNTY)

I hereby certify that the foregoing is, to the best of my knowledge and belief, a true and correct drilling log as shown by the drilling reports of the aforesaid well.

Keith Gallatin
 Keith Gallatin, Oberlin, Kansas

Subscribed and sworn to before me, the undersigned, a Notary Public, this 13 day of September, 1960.

Janice Bryan
 Notary Public

My commission expires June 18, 1962