

WELL PLUGGING RECORD

Give All Information Completely  
Make Required Affidavit  
Mail or Deliver Report to:  
Conservation Division  
State Corporation Commission  
211 No. Broadway  
Wichita, Kansas

Decatur County, Sec. 6 Twp. 3S Rge. 28 (W)

Location as "NE/CNW/SW" or footage from lines C NE SE

Lease Owner George R. Jones

Lease Name Robertson Well No. 1

Office Address Suite 1310, 125 No. Market, Wichita, Kansas 67202

Character of Well (completed as Oil, Gas or Dry Hole) dry hole

Date well completed April 11, 1979 19

Application for plugging filed 19

Application for plugging approved April 11, 1979 19


Plugging commenced April 11, 1979 19

Plugging completed April 11, 1979 19

Reason for abandonment of well or producing formation dry hole

If a producing well is abandoned, date of last production 19

Was permission obtained from the Conservation Division or its agents before plugging was commenced? yes

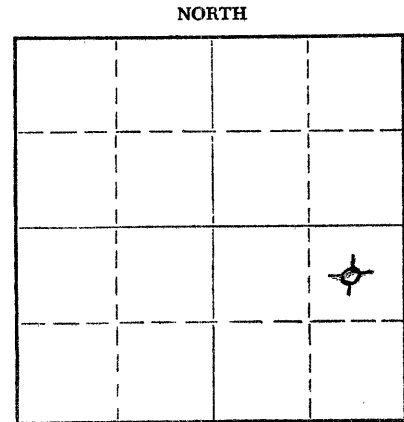

Locate well correctly on above Section Plat

Name of Conservation Agent who supervised plugging of this well Gilbert Balthazor

Producing formation Lansing-KC Depth to top Bottom Total Depth of Well 3900 Feet

Show depth and thickness of all water, oil and gas formations.

OIL, GAS OR WATER RECORDS

CASING RECORD

FORMATION	CONTENT	FROM	TO	SIZE	PUT IN	PULLED OUT
		Ran 8 jts of used 28# 8-5/8" 250/sx 60-40 POZ mix; cement down at 11:15 p.m. 4/6/79			csg; set at 329' with circulated; plug	

Describe in detail the manner in which the well was plugged, indicating where the mud fluid was placed and the method or methods used in introducing it into the hole. If cement or other plugs were used, state the character of same and depth placed, from feet to feet for each plug set.

4/11/79 - reached T.D. at 3900'  
set first plug @ 1300' w/70 sx  
second plug @ 300' w/20 sx  
third plug @ 40' w/solid bridge, w/10 sx  
rat hole 5 sx  
cemented 50-50 POZ, 6% gel  
plug down at 11:45 p.m. 4/11/79

RECEIVED  
STATE CORPORATION COMMISSION

04-20-1979  
APR 20 1979

CONSERVATION DIVISION  
Wichita, Kansas

(If additional description is necessary, use BACK of this sheet)

Name of Plugging Contractor Abercrombie Drilling, Inc.

Address 801 Union Center, Wichita, Kansas 67202

STATE OF KANSAS, COUNTY OF SEDGWICK, ss.


George R. Jones (employee of owner) or (owner or operator) of the above-described well, being first duly sworn on oath, says: That I have knowledge of the facts, statements, and matters herein contained and the log of the above-described well as filed and that the same are true and correct. So help me God.

(Signature) George R. Jones  
Suite 1310, 125 No. Market, Wichita, Kansas 67202 (Address)

SUBSCRIBED AND SWORN TO before me this 19th day of April, 1979

Wilma E. Clark  
Notary Public

My commission expires August 5, 1980

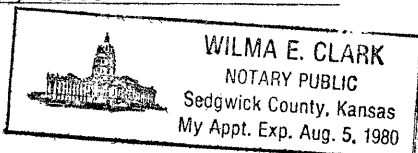

15-039-20452-00-00

CONTRACTOR WELL LOG

OPERATOR: George Jones  
 CONTRACTOR: Abercrombie Drilling, Inc.  
 WELL NAME: Robertson #1  
 LOCATION: NE SE, Section 6-3S-28W  
 Decatur County, Kansas  
 SPUD DATE: April 06, 1979  
 COMPLETION DATE: April 11, 1979

0	332	Surface soil, sand and shale
332	1303	Shale
1303	1925	Shale and sand
1925	2352	Shale
2352	2383	Anhydrite
2383	2625	Shale
2625	2863	Lime and shale
2863	3365	Shale and lime
3365	3595	Lime and shale
3595	3700	Shale and lime
3700	3715	Lime and shale
3715	3838	Shale and lime
3838	3900	Lime
	3900	Rotary Total Depth

Spud hole at 5:00 p.m., April 06, 1979. Drilled 332' of 12 1/4" hole. Ran 8 joints of used 28# casing. Set at 329' with 250 sacks of 60/40 posmix. Cement did circulate. Plug was down at 11:15 p.m., April 06, 1979.

T.D. 3900'. Set 1st plug at 1300' with 70 sacks, 2nd plug at 300' with 20 sacks, 3rd plug at 40' solid bridge with 10 sacks, rathole with 5 sacks. Cemented with 50/50 posmix, 6% gel. Plug was down at 11:45 p.m., April 11, 1979.

SAMPLE TOPS:

Anhydrite 2352'  
 B/Anhydrite 2383'

RECEIVED  
 STATE CORPORATION COMMISSION  
 APR 20 1979

STATE OF KANSAS )  
 ) ss  
 COUNTY OF SEDGWICK )

CONSERVATION DIVISION  
 Wichita, Kansas

Jack L. Partridge, Assistant Secretary-Treasurer of Abercrombie Drilling, Inc., does hereby state that the above and foregoing is a true and correct copy of the log of the Robertson #1, NE SE, Section 6-3S-28W, Decatur County, Kansas.

ABERCROMBIE DRILLING, INC.

BY Jack L. Partridge  
 Jack L. Partridge  
 Assistant Secretary-Treasurer

Subscribed and sworn to before me, a Notary Public, in and for the county and state aforesaid, as of the 19th day of April, 1979.



Sherrie L. Brooks  
 Sherrie Brooks, Notary Public

My commission expires 8-21-82.

15-039 - 20452-00-00

ABERCROMBIE DRILLING, INC.

801 UNION CENTER  
WICHITA, KANSAS 67202

ROBERTSON #1 (Rig #10)  
NE SE  
Section 6-3S-28W  
Decatur County, Kansas

OPERATOR: George Jones  
CONTRACTOR: Abercrombie Drilling, Inc.

TEST: B/KC (Approx. 3900')

George Jones  
125 N. Market, Suite 1310  
Wichita, Kansas 67202  
262-5503

ELEVATION: 2660' G.L. (L.S.)  
2666' D.F.  
2668' K.B.

APR 15 1979

04-07-79 Spud hole at 5:00 p.m., 4-06-79. Drilled 332' of 12 1/4" hole. Ran 8 joints of used 28# casing. (Overall tally 321.55') Set at 329' with 250 sacks of 60/40 posmix. Cement did circulate. Plug was down at 11:15 p.m., 4-06-79.  
7:15 a.m., 4-07-79 - Drilled plug.  
04-08-79 Drilling @ 2333'  
04-09-79 Drilling @ 3145'  
04-10-79 3700' preparing to start out for DST #1.  
04-11-79 Drilling @ 3840'  
04-12-79 T.D. 3900'. Set 1st plug @ 1300' with 70 sacks, 2nd plug @ 300' with 20 sacks, 3rd plug @ 40' solid bridge with 10 sacks, rathole with 5 sacks. Cemented with 50/50 posmix, 6% gel. Plug was down at 11:45 p.m. 4-11-79. State Plugger - Gilbert Balthazor.

Deviation 332' - 1/4°  
Deviation 1960' - 1°

SAMPLE TOPS:

Anhydrite 2352' (+316)  
B/Anhydrite 2383' (+285)

RECEIVED  
STATE CORPORATION COMMISSION

APR 20 1979

CONSERVATION DIVISION  
Wichita, Kansas