

CARD MUST BE TYPED

State of Kansas

CARD MUST BE SIGNED

NOTICE OF INTENTION TO DRILL - CORRECTED

(see rules on reverse side)

Starting Date 03 01 88
month day year

API Number 15— D39-20,826-00-00 ✓ 0 *

* OPERATOR: License # 3750

SE NW 34 3 29 East
3300 Sec. Twp. S, Rg. West

* Name Turnpike Oil Company

3300 Ft. from South Line of Section

Address 5810 West 38th Ave., Suite 12

3300 Ft. from East Line of Section

City/State/Zip Denver, CO 80212

Contact Person Virgil Balke

Phone 303-431-4842

(Note: Locate well on Section Plat on reverse side)

CONTRACTOR: License # 6033

Nearest lease or unit boundary line 660 feet

Name Murfin Drilling Company

County Decatur

City/State Wichita, KS

Lease Name Muller Well # 6-34

Well Drilled For: Well Class: Type Equipment:

Ground surface elevation 2776 GL feet MSL

Oil SWD Infill Mud Rotary

Domestic well within 330 feet: yes no

Gas Inj Pool Ext. Air Rotary

Municipal well within one mile: yes no

OWWO Expl Wildcat Cable

Depth to bottom of fresh water 195 feet

Depth to bottom of usable water 240 feet

If OWWO: old well info as follows:

Surface pipe by Alternate: 1 2 _____

Operator

Surface pipe planned to be set 260

Well Name

Conductor pipe required None

Comp Date Old Total Depth

Projected Total Depth 4250 feet

I certify that well will comply with K.S.A. 55-101, et seq., plus eventually plugging hole to KCC specifications, Formation BKC

Date 3-14-88 Signature of Operator or Agent Jack F. Goss Title Ass't. Drlg. Mgr.

For KCC Use: Conductor Pipe Required feet; Minimum Surface Pipe Required 250 feet per Alt. 1 2

This Authorization Expires 8-26-88 Approved By JFH 4-18-88 DRIL. RCY'D. 2-26-88


* WAS: Lic. # 6033, Murfin Drilling Co., Wichita, KS

Must be filed with the K.C.C. five (5) days prior to commencing well
This card void if drilling not started within six (6) months of date received by K.C.C.

Important procedures to follow:

1. Notify District office before setting surface casing.
2. Set surface casing by circulating cement to the top.
3. File completion forms ACO-1 with K.C.C. within 90 days of well completion, following instructions on ACO-1, side 1, and including copies of wireline logs.
4. Notify District office 48 hours prior to old well workover or re-entry.
5. Prior to filing Intent, prepare a proposed plugging plan in case well is D & A, then obtain approval of plan when calling district office prior to setting surface pipe.
6. Submit plugging report (CP-4) to K.C.C. after plugging is completed.
7. Obtain an approved injection docket number before disposing of salt water.
8. Notify K.C.C. within 10 days when injection commences or terminates.
9. If an alternate 2 completion, cement in the production pipe from below any usable water to surface within 120 days of spud date.

A Regular Section of Land
1 Mile = 5,280 Ft.

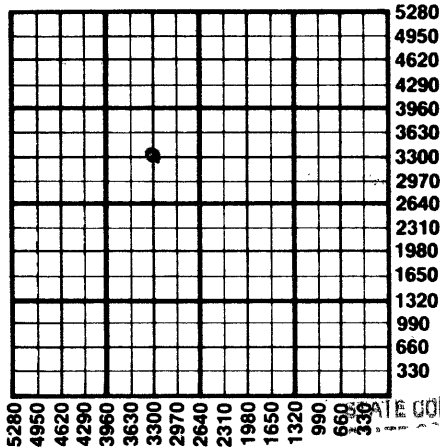

RECEIVED
STATE CORPORATION COMMISSION
APR 13 1988
4-18-88
CONSERVATION DIVISION
Wichita, Kansas

State Corporation Commission of Kansas
Conservation Division
200 Colorado Derby Building
Wichita, Kansas 67202
(313) 963-3238