

CARD MUST BE TYPED

State of Kansas
NOTICE OF INTENTION TO DRILL
(see rules on reverse side)

CARD MUST BE SIGNED

Starting Date: 08 12 85
month day year

API Number 15- 039-20,777-00-00

OPERATOR: License # 6033
Name Murfin Drilling Company
Address 250 N. Water, Suite 300
City/State/Zip Wichita, KS 67202
Contact Person Rob Ramseyer
Phone 316-267-3241

SW NE 34 Twp 3 S, Rge 29
(location) Sec 34
3300 Ft North from Southeast Corner of Section
1980 Ft West from Southeast Corner of Section
(Note: Locate well on Section Plat on reverse side)

CONTRACTOR: License # 6033
Name Murfin Drilling Company
City/State Wichita, KS

Nearest lease or unit boundary line 660 feet.
County Decatur
Lease Name Muller Well# 7-34

Well Drilled For: Well Class: Type Equipment:
 Oil Swd Infield Mud Rotary
 Gas Inj Pool Ext. Air Rotary
 OWWO Expl Wildcat Cable

Domestic well within 330 feet: yes no
Municipal well within one mile: yes no

If OWWO: old well info as follows:
Operator
Well Name
Comp Date Old Total Depth
Projected Total Depth 4150 feet
Projected Formation at TD KC
Expected Producing Formations BKC

Depth to Bottom of fresh water 100-182 feet
Lowest usable water formation Dakota Unconsolidated
Depth to Bottom of usable water 1500-225 feet
Surface pipe by Alternate: 1 225
Surface pipe to be set 225 feet
Conductor pipe if any required N/A feet
Ground surface elevation feet MSL
This Authorization Expires 2-9-86
Approved By 8-9-85

I certify that we will comply with K.S.A. 55-101, et seq., plus eventually plugging hole to K.C.C. specifications.

If producer, production string will be immediately cemented to surface.
Date 8-9-85 Signature of Operator or Agent Robert A. Ramseyer, Jr. Title Ass't. Drilg. Mgr.

Robert A. Ramseyer, Jr., Agent for Opr.


Form C-1 4/84

RCA FORKDAE

**Must be filed with the K.C.C. five (5) days prior to commencing well
This card void if drilling not started within six (6) months of date received by K.C.C.**

Important procedures to follow :

**A Regular Section of Land
1 Mile = 5,280 Ft.**

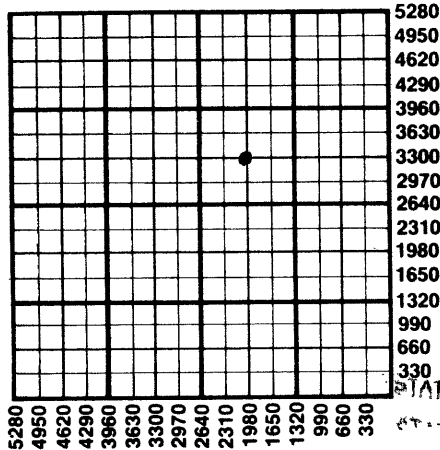

1. Notify District office before setting surface casing.
2. Set surface casing by circulating cement to the top.
3. File completion forms ACO-1 with K.C.C. within 90 days of well completion, following instructions on ACO-1, side 1, and including copies of wireline logs.
4. Notify District office 48 hours prior to old well workover or re-entry.
5. Prior to plugging, prepare a plugging plan, then obtain agreement from the appropriate district office for an approved plugging plan.
6. Submit plugging report (CP-4) to K.C.C. after plugging is completed.
7. Obtain an approved injection docket number before disposing of salt water.
8. Notify K.C.C. within 10 days when injection commences or terminates.
9. If an alternate 2 completion, cement in the production pipe from below and usable water to surface within 120 days of spud date.

RECEIVED
STATE CORPORATION COMMISSION

8-9-85
AUG 9 1985

CONSERVATION DIVISION
Wichita, Kansas

State Corporation Commission of Kansas
Conservation Division
200 Colorado Derby Building
Wichita, Kansas 67202
(316) 263-3238