

FOR KCC USE:

EFFECTIVE DATE:

DISTRICT # 4

SEA? Yes No

State of Kansas

NOTICE OF INTENTION TO DRILL

Must be approved by the K.C.C. five (5) days prior to commencing well

FORM C-1 7/91
FORM MUST BE TYPED
FORM MUST BE SIGNED
ALL BLANKS MUST BE FILLED

"00000" s/c/m

Expected Spud Date 10-30-91
month day year

Spot C SW SW Sec 18 Twp 3 S. Rg 35 East West

OPERATOR: License # 4599
Name: Larrette Resources
Address: 1127 Centennial Blvd.
City/State/Zip: Hays, Kansas 67601
Contact Person: LARRY J. Schaffer
Phone: 913-625-2820 / 913-628-6318 home

660'N feet from South / North line of Section
660'E feet from ~~East~~ / West line of Section

IS SECTION REGULAR IRREGULAR?
(NOTE: Locate well on the Section Plat on Reverse Side)

CONTRACTOR: License #: 30044
Name: Leon's Drilling Service

County: Rawlins
Beeson

Lease Name: Well # 1 "00000"
Field Name: Unnamed WILDCAT

Well Drilled For: Well Class: Type Equipment:
 Oil ... Enh Rec ... Infield ... Mud Rotary
... Gas ... Storage ... Pool Ext. ... Air Rotary
 OWO ... Disposal Wildcat Cable
... Seismic: # of Holes ... Other

Is this a Prorated/Spaced Field? ... yes no
Target Formation(s): Fort Scott
Nearest lease or unit boundary: 660'

Ground Surface Elevation: 3293KB feet MSU
Water well within one-quarter mile: yes no

If OWO: old well information as follows:
Operator: Empire Drilling Comp.
Well Name: Beeson # 1
Comp. Date: 9-2-62 Old Total Depth 4891'

Public water supply well within one mile: yes no
Depth to bottom of fresh water: 200'

Depth to bottom of usable water: 1915' 300'
Surface Pipe by Alternate: 1 X 2

Length of Surface Pipe Planned to be set: 309'
Length of Conductor pipe required: N/A

Projected Total Depth: 4700'
Formation at Total Depth: Miss

Water Source for Drilling Operations:
 well ... farm pond ... other

Directional, Deviated or Horizontal wellbore? ... yes no
If yes, true vertical depth:

DWR Permit #:
Will Cores Be Taken?: ... yes no
If yes, proposed zone:

**Prorated for Lansing / K.C. AFFIDAVIT*

Exception

The undersigned hereby affirms that the drilling, completion and eventual plugging of this well will comply with K.S.A. 55-101, et. seq.

It is agreed that the following minimum requirements will be met:

1. Notify the appropriate district office prior to spudding of well;
2. A copy of the approved notice of intent to drill shall be posted on each drilling rig;
3. The minimum amount of surface pipe as specified below shall be set by circulating cement to the top; in all cases surface pipe shall be set through all unconsolidated materials plus a minimum of 20 feet into the underlying formation;
4. If the well is dry hole, an agreement between the operator and the district office on plug length and placement is necessary prior to plugging;
5. The appropriate district office will be notified before well is either plugged or production casing is cemented in;
6. IF AN ALTERNATE II COMPLETION, PRODUCTION PIPE SHALL BE CEMENTED FROM BELOW ANY USABLE WATER TO SURFACE WITHIN 120 DAYS OF SPUD DATE. IN ALL CASES, NOTIFY DISTRICT OFFICE PRIOR TO ANY CEMENTING.

I hereby certify that the statements made herein are true and to the best of my knowledge and belief.

Date: 10-23-91 Signature of Operator or Agent: [Signature] Title: Pres.

RECEIVED
STATE CORPORATION COMMISSION
10-29-91
OCT 29 1991
CONSERVATION DIVISION
Wichita, Kansas

FOR KCC USE:
API # 15- 153-01,001-00-01
Conductor pipe required None feet
Minimum surface pipe required 309 feet per Alt. # 2
Approved by: [Signature] 11-5-91
This authorization expires: 5-5-92
(This authorization void if drilling not started within 6 months of effective date.)
Spud date: _____ Agent: _____

REMEMBER TO:

- File Drill Pit Application (form CDP-1) with Intent to Drill; no pit required
- File Completion Form ACO-1 within 120 days of spud date;
- File acreage attribution plat according to field proration orders;
- Notify appropriate district office 48 hours prior to workover or re-entry;
- Submit plugging report (CP-4) after plugging is completed;
- Obtain written approval before disposing or injecting salt water.

Mail to: Conservation Division, 200 Colorado Derby Building, 202 W. First St., Wichita, Kansas 67202-1286.

18
3
3500

IN ALL CASES PLOT THE INTENDED WELL ON THE PLAT BELOW

PLAT OF ACREAGE ATTRIBUTABLE TO A WELL IN A PRORATED OR SPACED FIELD

If the intended well is in a prorated or spaced field, please fully complete this side of the form. If the intended well is in a prorated or spaced field complete the plat below showing that the well will be properly located in relationship to other wells producing from the common source of supply. Please show all the wells within 1 mile of the boundaries of the proposed acreage attribution unit for gas wells and within 1/2 mile of the boundaries of the proposed acreage attribution unit for oil wells.

API NO. 15- _____
 OPERATOR Larrette Resources
 LEASE Beeson
 WELL NUMBER #1 "OWWO"
 FIELD UNNAMED WILDCAT

LOCATION OF WELL: COUNTY Rawlins
660' N feet from south/north line of section
660' E feet from east/west line of section
 SECTION 18 TWP 3 S RG 35 W



NUMBER OF ACRES ATTRIBUTABLE TO WELL 160
 QTR/QTR/QTR OF ACREAGE _____

IS SECTION X REGULAR or _____ IRREGULAR
IF SECTION IS IRREGULAR, LOCATE WELL FROM NEAREST CORNER BOUNDARY.

Section corner used: _____ NE _____ NW _____ SE _____ SW

PLAT

(Show location of the well and shade attributable acreage for prorated or spaced wells.)
 (Show footage to the nearest lease or unit boundary line.)

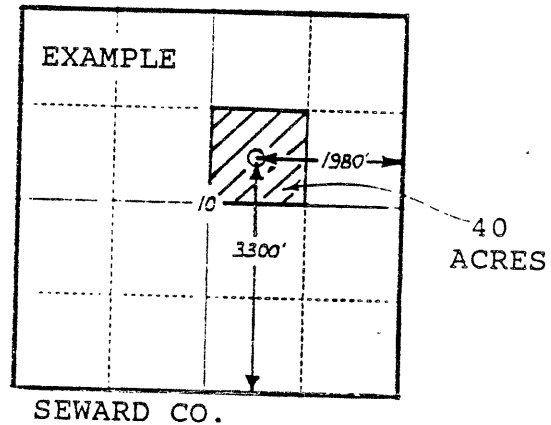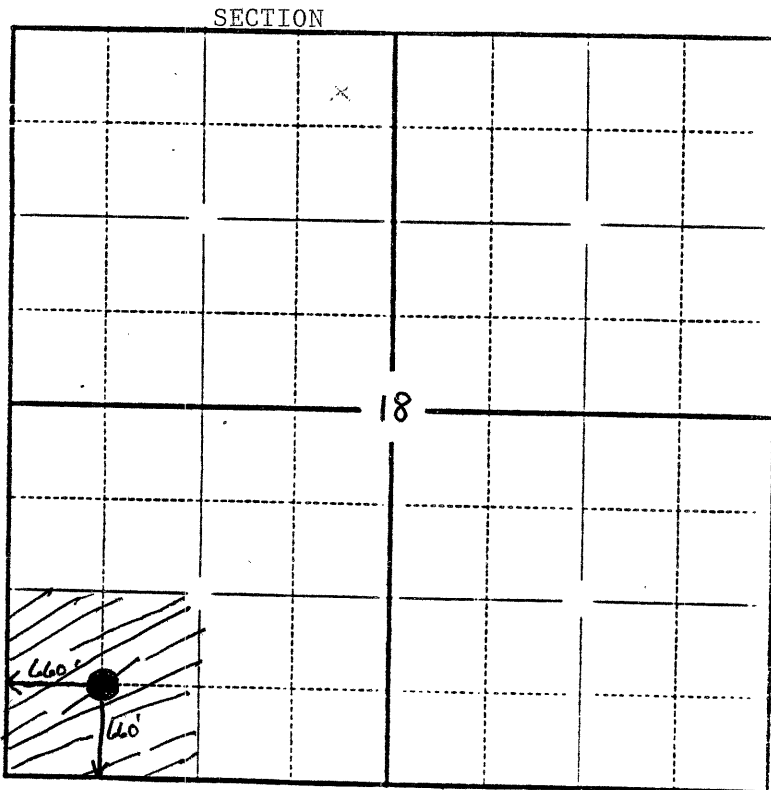

↑
40 ACRES

Rawlins County

In plotting the proposed location of the well, you must show:

- 1) The manner in which you are using the depicted plat by identifying section lines, i.e. 1 section, 1 section with 8 surrounding sections, 4 sections, etc.;
- 2) the distance of the proposed drilling location from the section's south/north and east/west lines; and
- 3) the distance to the nearest lease or unit boundary line.