

CARD MUST BE TYPED

State of Kansas
NOTICE OF INTENTION TO DRILL
(see rules on reverse side)

CARD MUST BE SIGNED

Starting Date: July 11, 1985
month day year

API Number 15- 039-20,770-00-00

OPERATOR: License # 6033
Name Murfin Drilling Company
Address 250 N. Water, Suite 300
City/State/Zip Wichita, Ks. 67202
Contact Person Todd Aikins
Phone 316-267-3241

NE. SW. NW. Sec 12. . Twp . 3 . S. Rge 28. .
(location) East West

. . . 3630 Ft North from Southeast Corner of Section
. . . 4290 Ft West from Southeast Corner of Section
(Note: Locate well on Section Plat on reverse side)

CONTRACTOR: License # 6033
Name Murfin Drilling Company
City/State Wichita, Ks. 67202

Nearest lease or unit boundary line 990 feet.
County Decatur
Lease Name Spiers Well# 1-12

Well Drilled For: Well Class: Type Equipment:
 Oil Swd Infield Mud Rotary
 Gas Inj Pool Ext. Air Rotary
 OWWO Expl Wildcat Cable

Domestic well within 330 feet : yes no
Municipal well within one mile : yes no

If OWWO: old well info as follows:

Operator
Well Name
Comp Date Old Total Depth
Projected Total Depth 3990 feet
Projected Formation at TD BKC
Expected Producing Formations Lansing - KC

Depth to Bottom of fresh water 60 150 feet
Lowest usable water formation unconsolidated
Depth to Bottom of usable water 60 200 feet
Surface pipe by Alternate : 1 2
Surface pipe to be set 200 feet
Conductor pipe if any required feet
Ground surface elevation feet MSI
This Authorization Expires 1-3-86
Approved By 7-3-85 RCH/KDHE

I certify that we will comply with K.S.A. 55-101, et seq., plus eventually plugging hole to K.C.C. specifications.

July 3, 1985
Date Signature of Operator or Agent Todd Aikins Title Geologist


Must be filed with the K.C.C. five (5) days prior to commencing well
 This card void if drilling not started within six (6) months of date received by K.C.C.

RECEIVED
 STATE CORPORATION COMMISSION

07-03-1985
 JUL 03 1985

Important procedures to follow:

A Regular Section of Land
1 Mile = 5,280 Ft.
 CONSERVATION DIVISION
 Wichita, Kansas

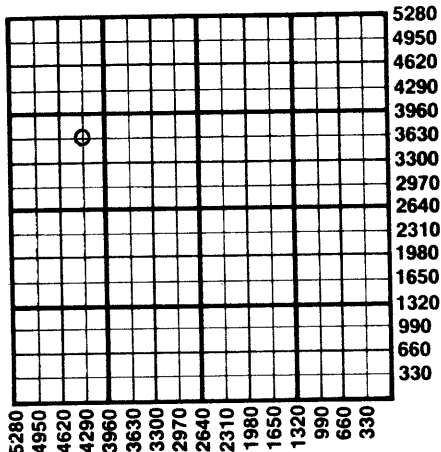

1. Notify District office before setting surface casing.
2. Set surface casing by circulating cement to the top.
3. File completion forms ACO-1 with K.C.C. within 90 days of well completion, following instructions on ACO-1, side 1, and including copies of wireline logs.
4. Notify District office 48 hours prior to old well workover or re-entry.
5. Prior to plugging, prepare a plugging plan, then obtain agreement from the appropriate district office for an approved plugging plan.
6. Submit plugging report (CP-4) to K.C.C. after plugging is completed.
7. Obtain an approved injection docket number before disposing of salt water.
8. Notify K.C.C. within 10 days when injection commences or terminates.
9. If an alternate 2 completion, cement in the production pipe from below any usable water to surface within 120 days of spud date.

State Corporation Commission of Kansas
Conservation Division
200 Colorado Derby Building
Wichita, Kansas 67202
(316) 263-3238