

CARD MUST BE TYPED

State of Kansas  
NOTICE OF INTENTION TO DRILL  
(see rules on reverse side)

CARD MUST BE SIGNED

Starting Date: July 3 1985  
month day year

API Number 15- 039-10, 768-00-00

OPERATOR: License # 5316  
Name Falcon Exploration Inc.  
Address 1531 KSB Bldg.  
City/State/Zip Wichita, KS 67202  
Contact Person Mike Mitchell  
Phone (316) 262-1378

SE NW  
(location) Sec 4 Twp 3 S, Rge 28  
 East  
 West  
3190 Ft North from Southeast Corner of Section  
3190 Ft West from Southeast Corner of Section  
(Note: Locate well on Section Plat on reverse side)

CONTRACTOR: License # 6033  
Name Murfin Drilling Co.  
City/State 250 N. Water, Suite 300

Nearest lease or unit boundary line 550 feet.  
County Decatur  
Lease Name Koerperich Well# 1

Well Drilled For: Well Class: Type Equipment:  
 Oil  Swd  Infield  Mud Rotary  
 Gas  Inj  Pool Ext.  Air Rotary  
 OWWO  Expl  Wildcat  Cable

Domestic well within 330 feet:  yes  no  
Municipal well within one mile:  yes  no

If OWWO: old well info as follows:  
Operator  
Well Name  
Comp Date Old Total Depth  
Projected Total Depth 3950 feet  
Projected Formation at TD LKC MARMATON  
Expected Producing Formations LKC

Depth to Bottom of fresh water 150 feet  
Lowest usable water formation unconsolidated mat'l  
Depth to Bottom of usable water 200 feet  
Surface pipe by Alternate: 1  2   
Surface pipe to be set 250 feet  
Conductor pipe if any required feet  
Ground surface elevation feet MSL  
This Authorization Expires 12-28-85  
Approved By 6-28-85 [Signature]

I certify that we will comply with K.S.A. 55-101, et seq., plus eventually plugging hole to K.C.C. specifications.

Date 6-28-85 Signature of Operator or Agent [Signature] Title President

Must be filed with the K.C.C. five (5) days prior to commencing well  
 This card void if drilling not started within six (6) months of date received by K.C.C.


RECEIVED  
 STATE CORPORATION COMMISSION  
 JUN 28 1985  
 JUN 2 R 1985

Important procedures to follow:

A Regular Section of Land  
 1 Mile = 5,280 Ft.

CONSERVATION DIVISION  
 Wichita, Kansas

1. Notify District office before setting surface casing.
2. Set surface casing by circulating cement to the top.
3. File completion forms ACO-1 with K.C.C. within 90 days of well completion, following instructions on ACO-1, side 1, and including copies of wireline logs.
4. Notify District office 48 hours prior to old well workover or re-entry.
5. Prior to plugging, prepare a plugging plan, then obtain agreement from the appropriate district office for an approved plugging plan.
6. Submit plugging report (CP-4) to K.C.C. after plugging is completed.
7. Obtain an approved injection docket number before disposing of salt water.
8. Notify K.C.C. within 10 days when injection commences or terminates.
9. If an alternate 2 completion, cement in the production pipe from below any usable water to surface within 120 days of spud date.

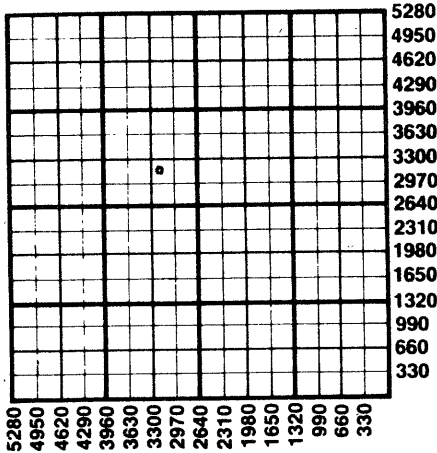

State Corporation Commission of Kansas  
 Conservation Division  
 200 Colorado Derby Building  
 Wichita, Kansas 67202  
 (316) 263-3238