

STATE OF KANSAS  
STATE CORPORATION COMMISSION


Give All Information Completely  
Make Required Affidavit  
Mail or Deliver Report to:  
Conservation Division  
State Corporation Commission  
212 North Market, Insurance Bldg.  
Wichita, Kansas

15-153-30140-00-00

WELL PLUGGING RECORD

Rawlins County, Sec. 9 Twp. 3S Rge. 32 W

Location as "NE/CNW/SW" or footage from lines C-SW-SE  
Lease Owner Amerada Petroleum Corporation  
Lease Name H. Wigner Well No. 1  
Office Address Box 197, Great Bend, Kansas  
Character of Well (completed as Oil, Gas or Dry Hole) Dry Hole  
Date well completed 1-5- 19 61  
Application for plugging filed 1-5- 19 61  
Application for plugging approved 1-5- 19 61  
Plugging commenced 10:45 p.m. 1-5- 19 61  
Plugging completed 12:15 p.m. 1-6- 19 61  
Reason for abandonment of well or producing formation Dry Hole

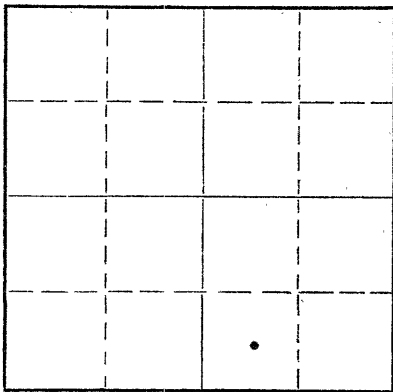

Locate well correctly on above Section Plat

If a producing well is abandoned, date of last production --- 19 ---  
Was permission obtained from the Conservation Division or its agents before plugging was commenced? Yes

Name of Conservation Agent who supervised plugging of this well A.D. Fabricius  
Producing formation --- Depth to top --- Bottom --- Total Depth of Well 4640 Feet  
Show depth and thickness of all water, oil and gas formations.

OIL, GAS OR WATER RECORDS

CASING RECORD

FORMATION	CONTENT	FROM	TO	SIZE	PUT IN	PULLED OUT
				8-5/8"	334'	None

Describe in detail the manner in which the well was plugged, indicating where the mud fluid was placed and the method or methods used in introducing it into the hole. If cement or other plugs were used, state the character of same and depth placed, from \_\_\_\_\_ feet to \_\_\_\_\_ feet for each plug set.

Filled hole with heavy mud to 500'  
Spotted Cement Plug @ 500' W/20 Sacks Cement  
Filled hole with heavy mud 500' to 320'  
Spotted Cement Plug @ 320' W/20 Sacks Cement  
Filled hole with heavy mud 320' to 40'  
Spotted Cement Plug @ 40' to Top W/12 sacks Cement  
Plugs Spotted By Halliburton Company Thru 4 1/2" Drill Pipe  
Plugging Authorized by A.D. Fabricius, State Pluggger, Hill City, Kansas

STATE CORP COM  
JAN 11 1961  
CONSERVATION DIV  
Wichita, Kan

(If additional description is necessary, use BACK of this sheet)

Name of Plugging Contractor Jelly Reaves Drilling Company  
Address Box 1264, Cushing, Oklahoma

STATE OF Kansas, COUNTY OF Barton, ss.  
A.D. Simpson (employee of owner) or (owner/operator) of the above-described well, being first duly sworn on oath, says: That I have knowledge of the facts, statements, and matters herein contained and the log of the above-described well as filed and that the same are true and correct. So help me God.

(Signature) [Signature]  
Box 197, Great Bend, Kansas  
(Address)

SUBSCRIBED AND SWORN to before me this 6th day of January, 19 61

[Signature]  
Notary Public.

My commission expires November 21, 1961



15-153-30140-00-00

AMERADA PETROLEUM CORPORATION  
WELL SUMMARY  
FORMATION DATA

WELL H. Wigner NO. 1 FIELD Wildcat-Ludell Area  
C-SW-SE, Section 9:3S-32W, Rawlins County, Kansas.

DRILLER'S LOG

8-5/8" OD 24# Casing Cemented  
W/300 Sacks Regular Bulk Cement  
W/2% Calcium Chloride Set @ 334'

<u>FROM</u>	<u>TO</u>	<u>FORMATION</u>
0'	1870'	Shale
1870'	2000'	Shale and Shells
2000'	2125'	Shale & Lime
2125'	2370'	Shale & Anhydrite
2370'	2448'	Shale W/streaks of Lime
2448'	2465'	Anhydrite
2465'	2550'	Shale
2550'	2565'	Anhydrite
2565'	2753'	Red Bed
2573'	2780'	Anhydrite
2780'	2910'	Shale & Lime
2910'	3080'	Shale and Sand
3080'	3250'	Shale
3250'	3355'	Shale & Lime
3355'	3485'	Lime & Shale
3485'	3620'	Lime and Sand
3620'	3702'	Lime & Shale
3702'	3870'	Lime
3870'	3992'	Lime & Shale
3992'	4305'	Lime
4305'	4410'	Lime & Shale
4410'	4470'	Shale
4470'	4568'	Lime & Shale W/Chert
4568'	4597'	Chert
4597'	4640'	Lime & Shale
4640'		Total Depth

Plugged and Abandoned.

RECEIVED  
STATE COURT AND COMMISSION

JAN 11 1961

01-11-1961

CONF