


WELL PLUGGING RECORD

Give All Information Completely
Make Required Affidavit
Mail or Deliver Report to:
Conservation Division
State Corporation Commission
211 No. Broadway
Wichita, Kansas

NORTH

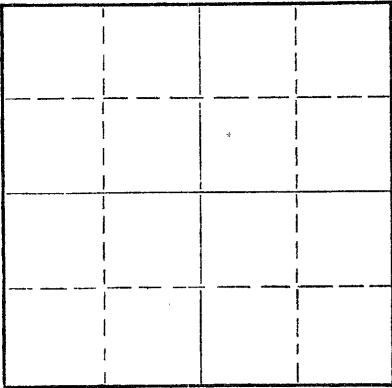

Locate well correctly on above
Section Plat

Rawlins County. Sec. 7 Twp. 3 Rge. 32 ~~XX~~ (W)
Location as "NE/CNW/SW" or footage from lines. C SW SE
Lease Owner Empire Drilling Company
Lease Name Holle Well No. 1
Office Address 650 Fourth National Bank Bldg., Wichita 2, Kansas
Character of Well (completed as Oil, Gas or Dry Hole) Dry Hole
Date well completed June 29 19 61
Application for plugging filed June 29 (verbally) 19 61
Application for plugging approved June 29 (verbally) 19 61
Plugging commenced June 29, 19 61
Plugging completed June 29, 19 61
Reason for abandonment of well or producing formation Dry Hole

If a producing well is abandoned, date of last production 19
Was permission obtained from the Conservation Division or its agents before plugging was commenced? Yes

Name of Conservation Agent who supervised plugging of this well Eldon Petty
Producing formation Depth to top Bottom Total Depth of Well 4285 Feet
Show depth and thickness of all water, oil and gas formations.

OIL, GAS OR WATER RECORDS

CASING RECORD

FORMATION	CONTENT	FROM	TO	SIZE	PUT IN	PULLED OUT
				8 5/8"	234"	None

Describe in detail the manner in which the well was plugged, indicating where the mud fluid was placed and the method or methods used in introducing it into the hole. If cement or other plugs were used, state the character of same and depth placed, from feet to feet for each plug set.

Plug set @ 600' w/ 20 sax cement
Plug set @ 200' w/ 20 sax cement
Plug set @ 40' w/ 10 sax cement

RECEIVED
STATE CORPORATION COMMISSION

JUL 14 1961
07-14-1961
CONSERVATION DIVISION
Wichita, Kansas

(If additional description is necessary, use BACK of this sheet)

Name of Plugging Contractor Empire Drilling Company
Address 650 Fourth National Bank Building, Wichita 2, Kansas

STATE OF KANSAS, COUNTY OF SEDGWICK, ss.
Dan J. Kornfeld (employee of owner) or (owner or operator) of the above-described well, being first duly sworn on oath, says: That I have knowledge of the facts, statements, and matters herein contained and the log of the above-described well as filed and that the same are true and correct. So help me God.

(Signature) Dan J. Kornfeld
650 Fourth National Bk. Bldg., Wichita 2, Kansas
(Address)

SUBSCRIBED AND SWORN TO before me this 6th day of July, 19 61

My commission expires October 21, 1962

Lucille H. Harr
Lucille H. Harr Notary Public.