


STATE OF KANSAS
STATE CORPORATION COMMISSION

Give All Information Completely
Make Required Affidavit
Mail or Deliver Report to:
Conservation Division
State Corporation Commission
800 Bitting Building
Wichita, Kansas

15-153-00009-00-00

WELL PLUGGING RECORD

NORTH

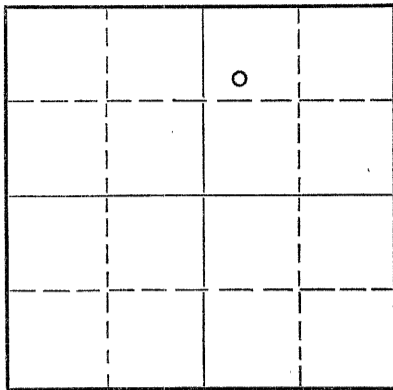

Locate well correctly on above
Section Plat

Rawlins County, Sec. 21 Twp. 3S Rge. (E) 32(W)

Location as "NE/CNW%SW%" or footage from lines SW NW NE
Lease Owner Natural Gas & Oil Corp. and Ashland Oil & Refg
Lease Name W. O. Lewis Well No. 1
Office Address 1009 Central Building, Wichita, Kansas
Character of Well (completed as Oil, Gas or Dry Hole) dry hole
Date well completed September 11, 1953 19
Application for plugging filed (Orally) September 11, 1953 19
Application for plugging approved Nov September 16, 1953 (Written) 19
Plugging commenced September 11, 1953 19
Plugging completed September 11, 1953 19
Reason for abandonment of well or producing formation _____

If a producing well is abandoned, date of last production _____ 19
Was permission obtained from the Conservation Division or its agents before plugging was commenced? yes

Name of Conservation Agent who supervised plugging of this well Eldon Petty, Box 326, Hays, Kansas
Producing formation _____ Depth to top _____ Bottom _____ Total Depth of Well _____ Feet
Show depth and thickness of all water, oil and gas formations.

OIL, GAS OR WATER RECORDS

CASING RECORD

FORMATION	CONTENT	FROM	TO	SIZE	PUT IN	PULLED OUT
surface		0	225	8 5/8"	225	none

Describe in detail the manner in which the well was plugged, indicating where the mud fluid was placed and the method or methods used in introducing it into the hole. If cement or other plugs were used, state the character of same and depth placed, from _____ feet to _____ feet for each plug set.

Filled with heavy mud from 4837 to 210 feet
Set plug and ran 15 sacks cement from 210 to 160 feet
Filled with heavy mud from 160 feet to 40 feet
Set plug and ran 10 sacks cement to cellar.

RECEIVED
STATE CORPORATION COMMISSION
SEP 19 1953
09-19-1953
CONSERVATION DIVISION
Wichita, Kansas

(If additional description is necessary, use BACK of this sheet)

Name of Plugging Contractor Drilling Department-Natural Gas and Oil Corporation
Address 1009 Central Building, Wichita 2, Kansas

STATE OF Kansas, COUNTY OF Sedgwick, ss.
Harold A. Burt (employee of owner) or ~~OWNER OR OPERATOR~~ of the above-described well, being first duly sworn on oath, says: That I have knowledge of the facts, statements, and matters herein contained and the log of the above-described well as filed and that the same are true and correct. So help me God.

(Signature) Harold A. Burt
1009 Central Building, Wichita, Ks
(Address)

SUBSCRIBED AND SWORN TO before me this 18th day of September, 19 53

Esther Russell
Notary Public.

My commission expires May 25, 1957

PLUGGING
FILE SEC 21 T 3 R 32W
BOOK PAGE 129 LINE 17