

15-153-00008-00-00

WELL PLUGGING RECORD


Give All Information Completely  
Make Required Affidavit  
Mail or Deliver Report to:  
Conservation Division  
State Corporation Commission  
800 Bitting Building  
Wichita, Kansas

Rawlins

County. Sec. 19 Twp. 3 Rge. (E)32 (W)

Location as "NE/CNW&SW¼" or footage from lines SE SE SW  
Lease Owner Natural Gas and Oil Corporation  
Lease Name W. O. Lewis "A" Well No. 1  
Office Address 1009 Central Building, Wichita 2, Kans  
Character of Well (completed as Oil, Gas or Dry Hole) dry hole  
Date well completed November 27, 1953 19  
Application for plugging filed November 27, 1953 (orally) 19  
Application for plugging approved November 27, 1953 " 19  
Plugging commenced November 27, 1953 19  
Plugging completed 1:30 A.M. November 27, 1953 19  
Reason for abandonment of well or producing formation \_\_\_\_\_

NORTH

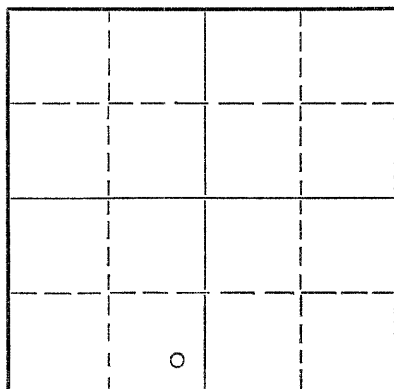

Locate well correctly on above  
Section Plat

If a producing well is abandoned, date of last production \_\_\_\_\_ 19  
Was permission obtained from the Conservation Division or its agents before plugging was commenced? yes

Name of Conservation Agent who supervised plugging of this well \_\_\_\_\_  
Producing formation \_\_\_\_\_ Depth to top \_\_\_\_\_ Bottom \_\_\_\_\_ Total Depth of Well \_\_\_\_\_ Feet  
Show depth and thickness of all water, oil and gas formations.

OIL, GAS OR WATER RECORDS

CASING RECORD

| FORMATION | CONTENT | FROM | TO  | SIZE   | PUT IN | PULLED OUT |
|-----------|---------|------|-----|--------|--------|------------|
| surface   |         | 0    | 220 | 8 5/8" | 220    | none       |
|           |         |      |     |        |        |            |
|           |         |      |     |        |        |            |
Describe in detail the manner in which the well was plugged, indicating where the mud fluid was placed and the method or methods used in introducing it into the hole. If cement or other plugs were used, state the character of same and depth placed, from \_\_\_\_\_ feet to \_\_\_\_\_ feet for each plug set.

Filled hole with heavy mud from 4666 T.D. to 210 feet  
Set plug at 210 feet and ran 15 sacks cement to 160 feet  
Filled hole with heavy mud from 160 feet to 40 feet  
Set plug at 40 feet and ran 10 sacks cement to cellar.

RECEIVED  
STATE CORPORATION COMMISSION  
DEC 31 1953  
12-03-1953  
CONSERVATION DIVISION  
Wichita, Kansas

(If additional description is necessary, use BACK of this sheet)  
Name of Plugging Contractor Drilling-Department-Natural Gas and Oil Corporation  
Address 1009 Central Building, Wichita 2, Kansas

STATE OF Kansas, COUNTY OF Sedgwick, ss.  
Harold A. Burt, Regional Manager (employee of owner) or (owner or operator) of the above-described well, being first duly sworn on oath, says: That I have knowledge of the facts, statements, and matters herein contained and the log of the above-described well as filed and that the same are true and correct. So help me God.

(Signature) Harold A. Burt  
1009 Central Building, Wichita, Ks  
(Address)

SUBSCRIBED AND SWORN TO before me this 1st day of December, 1953

Esther Unsell  
Esther Unsell Notary Public.

My commission expires May 25, 1957

PLUGGING  
FILE SEC 19 T 3 R 32  
BOOK PAGE 196 LINE 3