


STATE OF KANSAS  
STATE CORPORATION COMMISSION

Give All Information Completely  
Make Required Affidavit  
Mail or Deliver Report to:  
Conservation Division  
State Corporation Commission  
211 No. Broadway  
Wichita, Kansas

15-53-00049-00-00  
WELL PLUGGING RECORD

NORTH

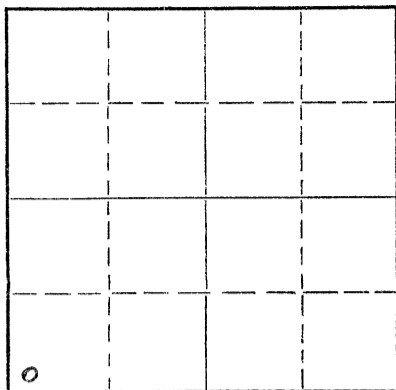

Locate well correctly on above  
Section Plat

Rawlins County. Sec. 23 Twp. 3S Rge. 31 (E) (WW)  
Location as "NE/CNW/SW" or footage from lines. SW SW SW  
Lease Owner Sauvage Drl'g Co., & General Crude Oil Co.  
Lease Name Cederberg Well No. 1  
Office Address Oberlin, Kansas  
Character of Well (completed as Oil, Gas or Dry Hole) Dry hole  
Date well completed 10-25-59 19  
Application for plugging filed 10-30-59 19  
Application for plugging approved 10-30-59 19  
Plugging commenced 10-31-59 19  
Plugging completed 10-31-59 19  
Reason for abandonment of well or producing formation Dry

If a producing well is abandoned, date of last production \_\_\_\_\_ 19\_\_\_\_  
Was permission obtained from the Conservation Division or its agents before plugging was commenced? Yes

Name of Conservation Agent who supervised plugging of this well A. D. Fabricius  
Producing formation \_\_\_\_\_ Depth to top \_\_\_\_\_ Bottom \_\_\_\_\_ Total Depth of Well 4605 Feet  
Show depth and thickness of all water, oil and gas formations.

OIL, GAS OR WATER RECORDS

CASING RECORD

FORMATION	CONTENT	FROM	TO	SIZE	PUT IN	PULLED OUT
				8-5/8"	220	Left in hole

Describe in detail the manner in which the well was plugged, indicating where the mud fluid was placed and the method or methods used in introducing it into the hole. If cement or other plugs were used, state the character of same and depth placed, from \_\_\_\_\_ feet to \_\_\_\_\_ feet for each plug set.

Filled hole with heavy mud to 500 feet - set plug with 20 sax cement - filled hole to 220 feet - set plug with 20 sax cement - filled with mud to 40 feet - set plug with 10 sax cement and fill hole to bottom of cellar.

RECEIVED  
STATE CORPORATION COMMISSION

NOV 3 1959  
11-03-1959  
CONSERVATION DIVISION  
Wichita, Kansas

(If additional description is necessary, use BACK of this sheet)

Name of Plugging Contractor Sauvage Drilling Co., Inc.  
Address \_\_\_\_\_

STATE OF Kansas, COUNTY OF Decatur, ss.  
Keith Gallatin (employee of owner) or (owner or operator) of the above-described well, being first duly sworn on oath, says: That I have knowledge of the facts, statements, and matters herein contained and the log of the above-described well as filed and that the same are true and correct. So help me God.

(Signature) Keith Gallatin  
Keith Gallatin  
Oberlin, Kansas  
(Address)

SUBSCRIBED AND SWORN TO before me this 31st day of October, 19 59

My commission expires June 18, 1962  
Janice Bryan Notary Public.

