

15-153-30136-00-01


STATE OF KANSAS
STATE CORPORATION COMMISSION

Form CP-4

Give All Information Completely
Make Required Affidavit
Mail or Deliver Report to:
Conservation Division
State Corporation Commission
P. O. Box 17027
Wichita, Kansas 67217
NORTH

WELL PLUGGING RECORD

Rawlins County. Sec. 5 Twp. 3S Rge. ~~xx 31~~ (W)
Location as "NE/CNW/SW" or footage from lines C SE SW
Lease Owner Halliburton Oil Producing Company
Lease Name Jenks Well No. 1
Office Address 2915 Classen Blvd., Oklahoma City, Okla. 73106
Character of Well (completed as Oil, Gas or Dry Hole) Oil
Date well completed 12-12 19.75
Application for plugging filed 8-27 19.76
Application for plugging approved 8-31 19.76
Plugging commenced 9-17 19.76
Plugging completed 9-17 19.76
Reason for abandonment of well or producing formation Not economical

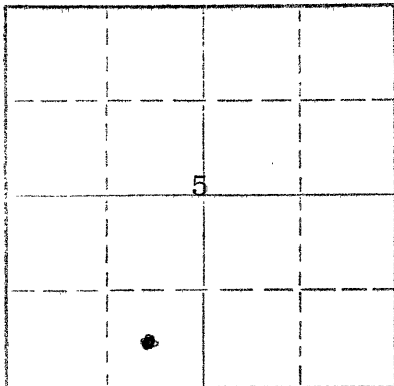

Locate well correctly on above
Section Plat

If a producing well is abandoned, date of last production 8-25 19.76
Was permission obtained from the Conservation Division or its agents before plugging was commenced? Yes

Name of Conservation Agent who supervised plugging of this well Gilbert Balthazor
Producing formation Lansing Depth to top 4098' Bottom 4182' Total Depth of Well 4270 Feet
Show depth and thickness of all water, oil and gas formations.

OIL, GAS OR WATER RECORDS

CASING RECORD

| FORMATION | CONTENT | FROM | TO | SIZE | PUT IN | PULLED OUT |
|-----------|---------|-------|-------|--------|--------|------------|
| Lansing | Oil | 4098' | 4182' | 8-5/8" | 215' | None |
| | | | | 4-1/2" | 4269' | 1700' |
| | | | | | | |
| | | | | | | |
| | | | | | | |
| | | | | | | |

Describe in detail the manner in which the well was plugged, indicating where the mud fluid was placed and the method or methods used in introducing it into the hole. If cement or other plugs were used, state the character of same and depth placed, from _____ feet to _____ feet for each plug set.

Filled hole, mix 3 sx. hulls, 70 sx. cement with 6% gel and pump in hole. Plug 1470-1785'. Mix 60 sx. cement plug - 270' back to surface. Cut off surface casing and cap well.

RECEIVED
STATE CORPORATION COMMISSION

OCT 08 1976
10-08-1976
CONSERVATION DIVISION
Wichita, Kansas

(If additional description is necessary, use BACK of this sheet)
Name of Plugging Contractor D & L Well Service - Supervised by Karol Claypool,
Address Box 10, Stafford, Kansas 67578

STATE OF Oklahoma COUNTY OF Oklahoma, ss.
D. D. Swearingen (employee of owner) ~~XXXXXXXXXXXXXXXX~~ of the above-described well, being first duly sworn on oath, says: That I have knowledge of the facts, statements, and matters herein contained and the log of the above-described well as filed and that the same are true and correct. So help me God.

(Signature) D. D. Swearingen, Prod. Supt.
2915 Classen Blvd., Okla. City, Okla.
(Address)

SUBSCRIBED AND SWORN TO before me this 7th day of October, 1976

My commission expires April 24, 1977

Heber C. Payne
Notary Public.