


STATE OF KANSAS
STATE CORPORATION COMMISSION

Give All Information Completely
Make Required Affidavit
Mail or Deliver Report to:
Conservation Division
State Corporation Commission
211 No. Broadway
Wichita, Kansas

15-153-30136-00-00
WELL PLUGGING RECORD

NORTH

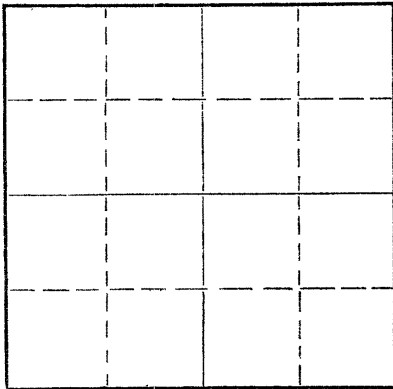

Locate well correctly on above
Section Plat

Rawlins County. Sec. 5 Twp. 35 Rge. 31 (E) (W)*
Location as "NE/CNW/SW" or footage from lines C SE SW
Lease Owner Empire Drilling Company
Lease Name Falconer Well No. 1
Office Address 650 Fourth National Bank Building, Wichita, Kansas
Character of Well (completed as Oil, Gas or Dry Hole) Dry Hole
Date well completed March 12, 1961 19
Application for plugging filed March 12, 1961 19
Application for plugging approved March 12, 1961 19
Plugging commenced March 12, 1961 19
Plugging completed March 12, 1961 19
Reason for abandonment of well or producing formation Dry Hole

If a producing well is abandoned, date of last production 19
Was permission obtained from the Conservation Division or its agents before plugging was commenced? yes

Name of Conservation Agent who supervised plugging of this well A. D. Fabricius
Producing formation Depth to top Bottom Total Depth of Well 4270 Feet
Show depth and thickness of all water, oil and gas formations.

OIL, GAS OR WATER RECORDS

CASING RECORD

FORMATION	CONTENT	FROM	TO	SIZE	PUT IN	PULLED OUT
	Sand-Shale	0	270	8 5/8"	215'	-0-

Describe in detail the manner in which the well was plugged, indicating where the mud fluid was placed and the method or methods used in introducing it into the hole. If cement or other plugs were used, state the character of same and depth placed, from feet to feet for each plug set.

Plug set at 400' with 20 sacks cement.
Plug set at 210' with 20 sacks cement.
Plug set at 40' with 10 sacks cement.

RECEIVED
STATE CORPORATION COMMISSION

MAR 21 1961
03-21-1961
CONSERVATION DIVISION
Wichita, Kansas

(If additional description is necessary, use BACK of this sheet)

Name of Plugging Contractor Empire Drilling Company
Address 650 Fourth National Bank Building, Wichita, Kansas

STATE OF KANSAS, COUNTY OF SEDGWICK, ss.

Dan J. Kornfeld (employee of owner) (owner or operator) of the above-described well, being first duly sworn on oath, says: That I have knowledge of the facts, statements, and matters herein contained and the log of the above-described well as filed and that the same are true and correct. So help me God.

(Signature) *Dan J. Kornfeld*
650-4th Nat'l. Bank Bldg, Wichita, Kansas
(Address)

SUBSCRIBED AND SWORN to before me this 15th day of March, 1961

My commission expires October 21, 1962

Lucille H. Harr
Lucille H. Harr
Notary Public.

