


15-039-00151-00-00

STATE OF KANSAS
STATE CORPORATION COMMISSION

Give All Information Completely
Make Required Affidavit
Mail or Deliver Report to:
Conservation Division
State Corporation Commission
211 No. Broadway
Wichita, Kansas

WELL PLUGGING RECORD

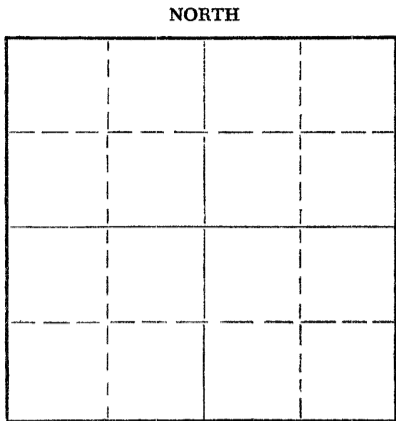

Locate well correctly on above
Section Plat

Decatur County. Sec. 3 Twp. 3S Rge. 30W(E) (W)
Location as "NE/CNW/SW" or footage from lines NE NE NE
Lease Owner M. J. Lebsack
Lease Name Unger Well No. 1
Office Address 502 Kittridge Bldg., Denver, Colorado
Character of Well (completed as Oil, Gas or Dry Hole) Dry Hole
Date well completed 5-29-59 19
Application for plugging filed 5-29-59 19
Application for plugging approved 5-29-59 19
Plugging commenced 5-29-59 19
Plugging completed 5-29-59 19
Reason for abandonment of well or producing formation Dry Hole

If a producing well is abandoned, date of last production _____ 19
Was permission obtained from the Conservation Division or its agents before plugging was commenced? Yes

Name of Conservation Agent who supervised plugging of this well A. D. Fabricius
Producing formation _____ Depth to top _____ Bottom _____ Total Depth of Well 4396 Feet
Show depth and thickness of all water, oil and gas formations.

OIL, GAS OR WATER RECORDS

CASING RECORD

FORMATION	CONTENT	FROM	TO	SIZE	PUT IN	PULLED OUT
				8 5/8"	240'	

Describe in detail the manner in which the well was plugged, indicating where the mud fluid was placed and the method or methods used in introducing it into the hole. If cement or other plugs were used, state the character of same and depth placed, from _____ feet to _____ feet for each plug set.

1st plug @ 600' w/ 20 sx. cmt.
2nd plug @ 240' w/ 20 sx. cmt.
3rd plug @ 40' w/ 10 sx. cmt.

RECEIVED
STATE CORPORATION COMMISSION

JUN 9 1959

CONSERVATION DIVISION
Wichita, Kansas

6-9-59

(If additional description is necessary, use BACK of this sheet)
Name of Plugging Contractor Leben Drilling, Inc.
Address 905 Central Bldg., Wichita, Kansas

STATE OF KANSAS, COUNTY OF SEDGWICK, ss.
Theodore I. Leben (employee of owner) or (owner or operator) of the above-described well, being first duly sworn on oath, says: That I have knowledge of the facts, statements, and matters herein contained and the log of the above-described well as filed and that the same are true and correct. So help me God.

(Signature) Theodore I. Leben
905 Central Bldg., Wichita, Kansas
(Address)

SUBSCRIBED AND SWORN to before me this 2nd day of June, 19 59

My commission expires April 23, 1963

Juanita M. Green
Notary Public.

PLUGGING
FILE SEC. 3 T.3 R.30W
BOOK PAGE 44 LINE 20