

15-039-00082-00-00


STATE OF KANSAS  
STATE CORPORATION COMMISSION

WELL PLUGGING RECORD

Give All Information Completely  
Make Required Affidavit  
Mail or Deliver Report to:  
Conservation Division  
State Corporation Commission  
800 Bittling Building  
Wichita, Kansas

Decatur County. Sec. 26 Twp. 3 Rge. 29 (E) (W)  
Location as "NE/CNW/SW" or footage from lines NE NE NW  
Lease Owner W. W. Sauvage  
Lease Name W. W. Sauvage Well No. 2  
Office Address Oberlin, Kansas  
Character of Well (completed as Oil, Gas or Dry Hole) dry hole  
Date well completed October 2 19 54  
Application for plugging filed October 2 19 54  
Application for plugging approved October 2 19 54  
Plugging commenced October 14 19 54  
Plugging completed October 14 19 54  
Reason for abandonment of well or producing formation dry hole

NORTH

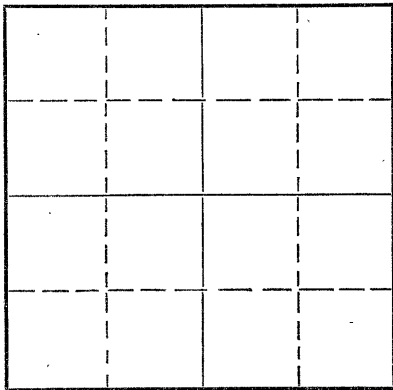

Locate well correctly on above  
Section Plat

If a producing well is abandoned, date of last production \_\_\_\_\_ 19\_\_\_\_  
Was permission obtained from the Conservation Division or its agents before plugging was commenced? yes

Name of Conservation Agent who supervised plugging of this well Eldon Petty  
Producing formation \_\_\_\_\_ Depth to top \_\_\_\_\_ Bottom \_\_\_\_\_ Total Depth of Well 4015 Feet  
Show depth and thickness of all water, oil and gas formations.

OIL, GAS OR WATER RECORDS

CASING RECORD

FORMATION	CONTENT	FROM	TO	SIZE	PUT IN	PULLED OUT

Describe in detail the manner in which the well was plugged, indicating where the mud fluid was placed and the method or methods used in introducing it into the hole. If cement or other plugs were used, state the character of same and depth placed, from \_\_\_\_\_ feet to \_\_\_\_\_ feet for each plug set.

Filled bottom hole with heavy mud and circulated set plug 195 feet  
1/2 sx hulls mixed 15 sx cement left top open for waterwell.

(If additional description is necessary, use BACK of this sheet)  
Name of Plugging Contractor Sauvage-Dunn Drilling Co., Inc. 10-15-54  
Address Oberlin, Kansas

STATE OF Kansas, COUNTY OF Decatur, ss.  
W. W. Sauvage (employee of owner) or (owner or operator) of the above-described well, being first duly sworn on oath, says: That I have knowledge of the facts, statements, and matters herein contained and the log of the above-described well as filed and that the same are true and correct. So help me God.

(Signature) W. W. Sauvage  
Oberlin, Kansas (Address)

SUBSCRIBED AND SWORN TO before me this 14th day of October, 19 54

My commission expires May 17th, 1955  
Opal Sauvage Notary Public.

