

15-039-00066-00-00


STATE OF KANSAS  
STATE CORPORATION COMMISSION

Give All Information Completely  
Make Required Affidavit  
Mail or Deliver Report to:  
Conservation Division  
State Corporation Commission  
800 Bitting Building  
Wichita, Kansas

WELL PLUGGING RECORD

Decatur County. Sec. 23 Twp. 3 Rge. 29 (E) (W)  
Location as "NE/CNW%SW%" or footage from lines 330 feet from N 3 3/4 from E  
Lease Owner W. W. Sauvage  
Lease Name Sauvage Well No. 1  
Office Address Oberlin, Kansas  
Character of Well (completed as Oil, Gas or Dry Hole) Dry Hole  
Date well completed 10-6 19 53  
Application for plugging filed 10-6 19 53  
Application for plugging approved 10-6 19 53  
Plugging commenced 10-6 19 53  
Plugging completed 10-6 19 53  
Reason for abandonment of well or producing formation Dry

NORTH

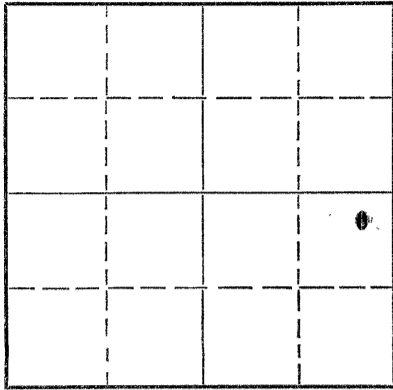

Locate well correctly on above  
Section Plat

If a producing well is abandoned, date of last production \_\_\_\_\_ 19\_\_\_\_  
Was permission obtained from the Conservation Division or its agents before plugging was commenced? Yes

Name of Conservation Agent who supervised plugging of this well Eldon Petty  
Producing formation \_\_\_\_\_ Depth to top \_\_\_\_\_ Bottom \_\_\_\_\_ Total Depth of Well 4337 Feet  
Show depth and thickness of all water, oil and gas formations.

OIL, GAS OR WATER RECORDS

CASING RECORD

FORMATION	CONTENT	FROM	TO	SIZE	PUT IN	PULLED OUT

Describe in detail the manner in which the well was plugged, indicating where the mud fluid was placed and the method or methods used in introducing it into the hole. If cement or other plugs were used, state the character of same and depth placed, from \_\_\_\_\_ feet to \_\_\_\_\_ feet for each plug set.

Filled the hole with heavy mud on bottom pulled pipe to 1500 feet and circulated with heavy mud. Pulled pipe and set plug at 160 feet 1/2 sx hulls and 15 sx cement through drill pipe and filled with mud to 40 feet with 1/2 sx hulls and 10 sx cement filled surface casing to the bottom cellar.

(If additional description is necessary, use BACK of this sheet)

Name of Plugging Contractor Sauvage-Dunn Drilling Co., Inc.  
Address Oberlin, Kansas

STATE OF Kansas COUNTY OF Decatur, ss.  
Emer Haff (employee of owner) or (owner or operator) of the above-described well, being first duly sworn on oath, says: That I have knowledge of the facts, statements, and matters herein contained and the log of the above-described well as filed and that the same are true and correct. So help me God.

(Signature) Emer Haff  
Oberlin, Kansas (Address)

SUBSCRIBED AND SWORN TO before me this 17<sup>th</sup> day of October, 19 53

My commission expires May 17, 1955  
Opal Sauvage Notary Public.

24-7366-S 3-53-20M

PLUGGING  
FILE SEC 23 T 3 R 29W  
BOOK PAGE 134 LINE 27

RECEIVED  
OCT 21 1953  
10-8-53  
CONSERVATION DIVISION  
WICHITA, KANSAS