


15-039-00110-00-00

STATE OF KANSAS
STATE CORPORATION COMMISSION

Give All Information Completely
Make Required Affidavit
Mail or Deliver Report to:
Conservation Division
State Corporation Commission
800 Bitting Building
Wichita, Kansas

WELL PLUGGING RECORD

Decatur County. Sec. 11 Twp. 3 Rge. 29 (E) (W)
Location as "NE/CNW¹/SW⁴" or footage from lines 330 ft.
Lease Owner W. W. Sauvage
Lease Name Sauvage Well No. I
Office Address Oberlin, Kansas
Character of Well (completed as Oil, Gas or Dry Hole) dry hole
Date well completed June 10 1955
Application for plugging filed June 10 1955
Application for plugging approved June 10 1955
Plugging commenced June 10 1955
Plugging completed June 10 1955
Reason for abandonment of well or producing formation dry

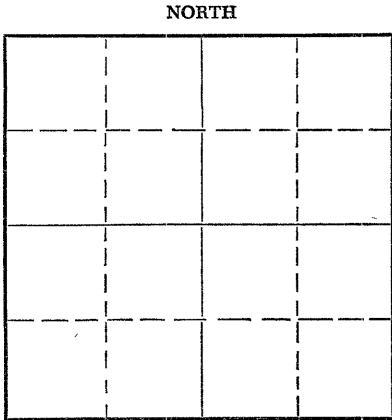

Locate well correctly on above
Section Plat

If a producing well is abandoned, date of last production _____ 19____
Was permission obtained from the Conservation Division or its agents before plugging was commenced? yes

Name of Conservation Agent who supervised plugging of this well Eldon Petty
Producing formation _____ Depth to top _____ Bottom _____ Total Depth of Well 4085 Feet
Show depth and thickness of all water, oil and gas formations.

OIL, GAS OR WATER RECORDS

CASING RECORD

FORMATION	CONTENT	FROM	TO	SIZE	PUT IN	PULLED OUT

Describe in detail the manner in which the well was plugged, indicating where the mud fluid was placed and the method or methods used in introducing it into the hole. If cement or other plugs were used, state the character of same and depth placed, from 4085 feet to 140 feet for each plug set.

Filled bottom of the hole with heavy mud thru drill pipe and circulated filled to 140 ft. set plug with 1/2 sx hulls and 15sx cement left top open for water well.

(If additional description is necessary, use BACK of this sheet)
Name of Plugging Contractor Sauvage & Dunn Drilling Co., Inc.
Address Oberlin, Kansas

STATE OF Kansas, COUNTY OF Decatur, ss.
owner (employee of owner) or (owner or operator) of the above-described well, being first duly sworn on oath, says: That I have knowledge of the facts, statements, and matters herein contained and the log of the above-described well as filed and that the same are true and correct. So help me God.

(Signature) W. W. Sauvage
Oberlin, Kansas (Address)

SUBSCRIBED AND SWORN TO before me this 15th day of June, 1955

My commission expires May 17, 1959

24-7368-5 3-53-20M

RECEIVED
STATE CORPORATION COMMISSION

JUN 17 1955

CONSERVATION DIVISION
Wichita Kansas

6-17-55

PLUGGING
FILE SEC 11 T 3 R 29W
BOOK PAGE 126 LINE 32