

CARD MUST BE TYPED

State of Kansas

CARD MUST BE SIGNED

### NOTICE OF INTENTION TO DRILL

(see rules on reverse side)

Starting Date ..... July 10 1986  
month day year

API Number 15— 153-20,655-0000

OPERATOR: License # ..... 8793

SE/4.NW/4... Sec..10.. Twp..3S.. S, Rg..36... — East

Name James Dillie

..... 3300 ..... Ft. from South Line of Section

Address 4469 So. Winona Ct.

..... 3300 ..... Ft. from East Line of Section

City/State/Zip Denver, Colorado 80236

(Note: Locate well on Section Plat on reverse side)

Contact Person James Dillie

Nearest lease or unit boundary line ..... 660 ..... feet

Phone 303-337-4800

County Rawlins

CONTRACTOR: License # .....

Lease Name Miller Well # 1-D

Name Unknown at this time

Ground surface elevation 3315 (est) ..... feet MSL

City/State .....

Domestic well within 330 feet: \_\_\_\_\_ yes  no

Well Drilled For: Well Class: Type Equipment:

Municipal well within one mile: \_\_\_\_\_ yes  no

Oil \_\_\_\_\_ SWD \_\_\_\_\_ Infield  Mud Rotary

Depth to bottom of fresh water ..... 300 .....

\_\_\_\_\_ Gas \_\_\_\_\_ Inj \_\_\_\_\_ Pool Ext. \_\_\_\_\_ Air Rotary

Depth to bottom of usable water ... 300-350 .....

\_\_\_\_\_ OWWO \_\_\_\_\_ Expl  Wildcat \_\_\_\_\_ Cable

Surface pipe by Alternate: 360 1 X 2 ~~4~~

If OWWO: old well info as follows:

Surface pipe planned to be set .....

Operator .....

Conductor pipe required .... N/A .....

Well Name .....

Projected Total Depth ..... 4800 ..... feet

Comp Date ..... Old Total Depth .....

Formation Cherokee .....

I certify that well will comply with K.S.A. 55-101, et seq., plus eventually plugging hole to KCC specifications.

Date 6/19/86 Signature of Operator or Agent James Dillie Title Operator

For KCC Use:

Conductor Pipe Required ..... feet; Minimum Surface Pipe Required ..... 350 ..... feet per Alt. 19


This Authorization Expires 12-11-86 Approved By 6-11-86 RCH/KOR

Must be filed with the K.C.C. five (5) days prior to commencing well  
This card void if drilling not started within six (6) months of date received by K.C.C.

**Important procedures to follow:**

1. Notify District office before setting surface casing.
2. Set surface casing by circulating cement to the top.
3. File completion forms ACO-1 with K.C.C. within 90 days of well completion, following instructions on ACO-1, side 1, and including copies of wireline logs.
4. Notify District office 48 hours prior to old well workover or re-entry.
5. Prior to filing Intent, prepare a proposed plugging plan in case well is D & A, then obtain approval of plan when calling district office prior to setting surface pipe.
6. Submit plugging report (CP-4) to K.C.C. after plugging is completed.
7. Obtain an approved injection docket number before disposing of salt water.
8. Notify K.C.C. within 10 days when injection commences or terminates.
9. If an alternate 2 completion, cement in the production pipe from below any usable water to surface within 120 days of spud date.

**A Regular Section of Land**  
**1 Mile = 5,280 Ft.**

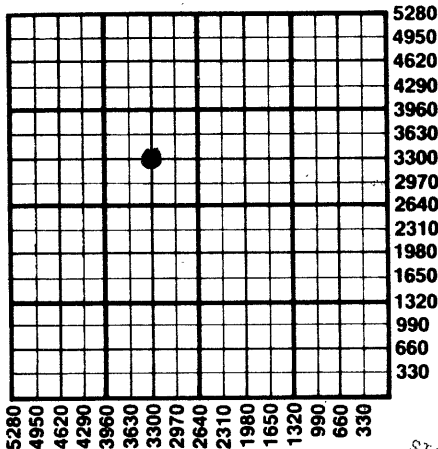

RECEIVED  
STATE CORPORATION COMMISSION

JUN 11 1986 6-11-86

CONSERVATION DIVISION  
Wichita, Kan

State Corporation Commission of Kansas  
Conservation Division  
200 Colorado Derby Building  
Wichita, Kansas 67202  
(316) 263-3238