

CARD MUST BE TYPED

State of Kansas

CARD MUST BE SIGNED

NOTICE OF INTENTION TO DRILL

(see rules on reverse side)

Starting Date May 21, 1986
month day year 405

API Number 15— 153-20, 654-00-00

OPERATOR: License # ~~8706~~ 8786
Name Edward Cahoj
Address Box 13
City/State/Zip McDonald, KS 67745
Contact Person Edward Cahoj
Phone (417) 326-4486

..... SE.. SW Sec. 10.. Twp. 3... S, Rg. 36... East
..... X West
..... 660 Ft. from South Line of Section
..... 3300 Ft. from East Line of Section

(Note: Locate well on Section Plat on reverse side)

CONTRACTOR: License # 8682
Name Golden Eagle Drilling Inc
City/State McCook, NE 69001

Nearest lease or unit boundary line 660 feet
County..... Rawlins.....
Lease Name... Faimon..... Well #... 10-14...
Ground surface elevation 3306 feet MSL
Domestic well within 330 feet: _____ yes X no
Municipal well within one mile: _____ yes X no
Surface pipe by Alternate: 1 X 2 _____
Depth to bottom of fresh water 300
Depth to bottom of usable water ... 325-350
Surface pipe planned to be set 400
Projected Total Depth 4780 feet
Formation.... Cherokee.....

Well Drilled For: Well Class: Type Equipment:
X Oil _____ SWD _____ Infield X Mud Rotary
_____ Gas _____ Inj _____ Pool Ext. _____ Air Rotary
_____ OWWO _____ Expl X Wildcat _____ Cable

If OWWO: old well info as follows:
Operator
Well Name
Comp Date Old Total Depth.....

I certify that well will comply with K.S.A. 55-101, et seq., plus eventually plugging hole to KCC specifications.

Date 5-19-86... Signature of Operator or Agent *Rebecca K. Crawford* Title... Agent.....


For KCC Use:
Conductor Pipe Required feet; Minimum Surface Pipe Required feet per A.P. 11-19-86
This Authorization Expires 11-19-86 Approved By 5-19-86

Must be filed with the K.C.C. five (5) days prior to commencing well
 This card void if drilling not started within six (6) months of date received by K.C.C.

Important procedures to follow:

1. Notify District office before setting surface casing.
2. Set surface casing by circulating cement to the top.
3. File completion forms ACO-1 with K.C.C. within 90 days of well completion, following instructions on ACO-1, side 1, and including copies of wireline logs.
4. Notify District office 48 hours prior to old well workover or re-entry.
5. Prior to filing Intent, prepare a proposed plugging plan in case well is D & A, then obtain approval of plan when calling district office prior to setting surface pipe.
6. Submit plugging report (CP-4) to K.C.C. after plugging is completed.
7. Obtain an approved injection docket number before disposing of salt water.
8. Notify K.C.C. within 10 days when injection commences or terminates.
9. If an alternate 2 completion, cement in the production pipe from below any usable water to surface within 120 days of spud date.

A Regular Section of Land
1 Mile = 5,280 Ft.

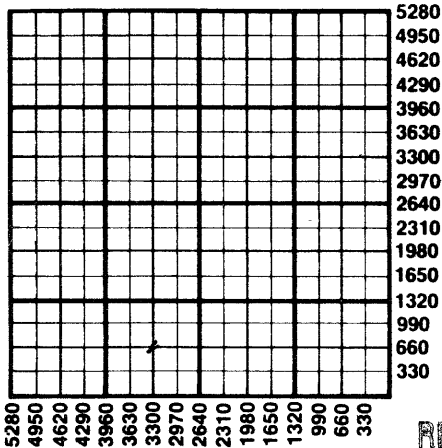

RECEIVED
 STATE CORPORATION COMMISSION

MAY 19 1986
 5-19-86
 CONSERVATION DIVISION
 Wichita, Kansas

State Corporation Commission of Kansas
 Conservation Division
 200 Colorado Derby Building
 Wichita, Kansas 67202
 (316) 263-3238