

CARD MUST BE TYPED

State of Kansas  
**NOTICE OF INTENTION TO DRILL**  
(see rules on reverse side)

CARD MUST BE SIGNED

Starting Date: 10/28/85  
month day year

OPERATOR: License # 9800  
Name Double R Oil Co. Inc.  
Address Box 506  
City/State/Zip McCook, Nebraska 69001  
Contact Person Roger W. Philpott  
Phone (913) 625-3104

CONTRACTOR: License # 6033  
Name Murfin Drilling Co.  
City/State Wichita, Kansas

Well Drilled For: Well Class: Type Equipment:  
 Oil  Swd  Infield  Mud Rotary  
 Gas  Inj  Pool Ext.  Air Rotary  
 OWWO  Expl  Wildcat  Cable

If OWWO: old well info as follows:

Operator Mobile C. Hoover  
Well Name Palmer # 1  
Comp Date 10/10/80 Old Total Depth 4773  
Projected Total Depth 4500 feet  
Projected Formation at TD Cherokee  
Expected Producing Formations LKC & Cherokee

I certify that we will comply with K.S.A. 55-101, et seq., plus eventually plugging hole to K.C.C. specifications.

Date 10/20/85 Signature of Operator or Agent

*Roger W. Philpott*

Title

Sec-Treas

Form C-1 4/84

API Number 15-153-20,400-00-01  
C SW SW Sec 36 Twp 3 S, Rge 34  
(location) 660 Ft North from Southeast Corner of Section  
4620 Ft West from Southeast Corner of Section  
(Note: Locate well on Section Plat on reverse side)

Nearest lease or unit boundary line 660 feet.  
County Rawlins  
Lease Name Palmer Well# 1-1336  
Domestic well within 330 feet:  yes  no  
Municipal well within one mile:  yes  no

Depth to Bottom of fresh water 200 feet  
Lowest usable water formation  
Depth to Bottom of usable water 250 feet  
Surface pipe by Alternate: 1  2   
Surface pipe to be set 8 5/8 @ 320 ft already set  
Conductor pipe if any required  
Ground surface elevation 3109 feet MSL  
This Authorization Expires 4-25-86  
Approved By 10-25-85 *E. RESTORER*


Must be filed with the K.C.C. five (5) days prior to commencing well  
This card void if drilling not started within six (6) months of date received by K.C.C.

RECEIVED  
STATE CORPORATION COMMISSION

A Regular Section of Land  
1 Mile = 5,280 Ft.

OCT 25 1985  
10-25-1985  
CONSERVATION DIVISION  
Wichita, Kansas

**Important procedures to follow:**

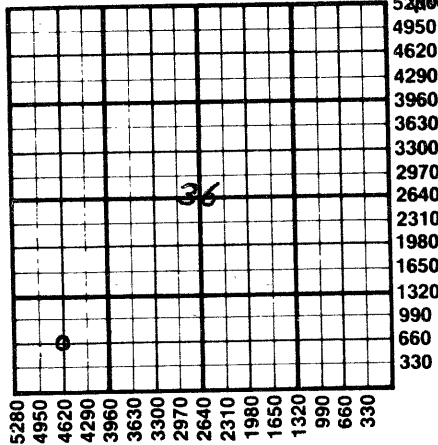

1. Notify District office before setting surface casing.  
Set surface casing by circulating cement to the top.
2. File completion forms ACO-1 with K.C.C. within 90 days of well completion, following instructions on ACO-1, side 1, and including copies of wireline logs.
4. Notify District office 48 hours prior to old well workover or re-entry.
5. Prior to plugging, prepare a plugging plan, then obtain agreement from the appropriate district office for an approved plugging plan.
6. Submit plugging report (CP-4) to K.C.C. after plugging is completed.
7. Obtain an approved injection docket number before disposing of salt water.
8. Notify K.C.C. within 10 days when injection commences or terminates.
9. If an alternate 2 completion, cement in the production pipe from below any usable water to surface within 120 days of spud date.

State Corporation Commission of Kansas  
Conservation Division  
200 Colorado Derby Building  
Wichita, Kansas 67202  
(316) 263-3238